


CREEKSIDE DRIVE

WATER CONNECTION


UNIT	TAP STATION	REVISIONS
1	1+28	12/97 PER D.O.E.S.
2	1+74	12/97 PER C.W.D.
3	2+28	
4	2+50	
5	3+28	
6	3+34	
7	3+94	
8	4+14	
9	4+72	
10	5+38	
11	5+44	
12	6+08	
13	6+15	
14	6+77	
15	6+82	
16	7+27	
17	7+37	
18	7+44	
19	7+53	
20	7+04	
21	6+89	
22	5+50	
23	4+20	
24	2+77	
25	2+04	
26	1+22	

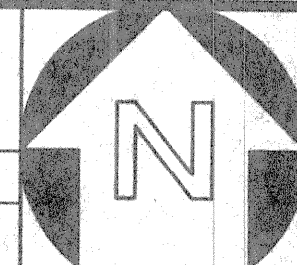

APPROVED AS NOTED
BY: *[Signature]* DATE: 10/27/98
SEYMOUR D. WEISS & ASSOCIATES

LOCATION PLAN
"CREEKSIDE" CLUSTER DEVELOPMENT
EATON ESTATE
SAGAMORE HILLS, OHIO

DONALD G. BOHNING & ASSOCIATES, INC.
CIVIL ENGINEERING & SURVEYING
7979 HUB PARKWAY • VALLEY VIEW, OHIO 44125
PHONE: (216) 642-1130 FAX: (216) 642-1132
W. LACORDY P.L. 2261-62 (L) 12-23-97 1:52.39 ppm EST

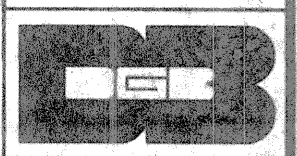

HORIZ. SCALE
1" = 50'

VERT. SCALE
1" = 5'

DRN. J.H. C.D. D.G.

DATE OCT., 1997

ORDER NO. 2261-62


ALL SANITARY SEWERS ARE TO BE PUBLICLY OWNED AND MAINTAINED. ALL SANITARY CONNECTIONS ARE TO BE PRIVATELY OWNED AND MAINTAINED.

6
13

0+26 EXTG. ST. MH. No. 3 (67'L)
CORE HOLE FOR 12" ST.
INV. 12" 995.29
0+30 REMOVE FL. PIPE & BOX ASS'Y.
INSTALL 8" L.V. & BOX (41'L)
0+36 8"- 11 1/4" BEND (41'L)
0+44 I.B. No. 1 (14.5'R)
T.C. 1001.67
INV. 997.67
0+44 C.B. No. 2 (30.5'L)
T.C. 1001.22
INV. 996.97
0+46 CHLOR. PIT
1+37 SAN. MH. No. 239 (22'R)
1+46 8"- 22 1/2" BEND (17'L)
1+67 HYD. ASS'Y

2+15 BEGIN 300' W.M. RAD.
2+74 END 300' W.M. RAD.

3+45 SAN. MH. No. 238 (38'R)
3+51 8"- 45" BEND (15'L)

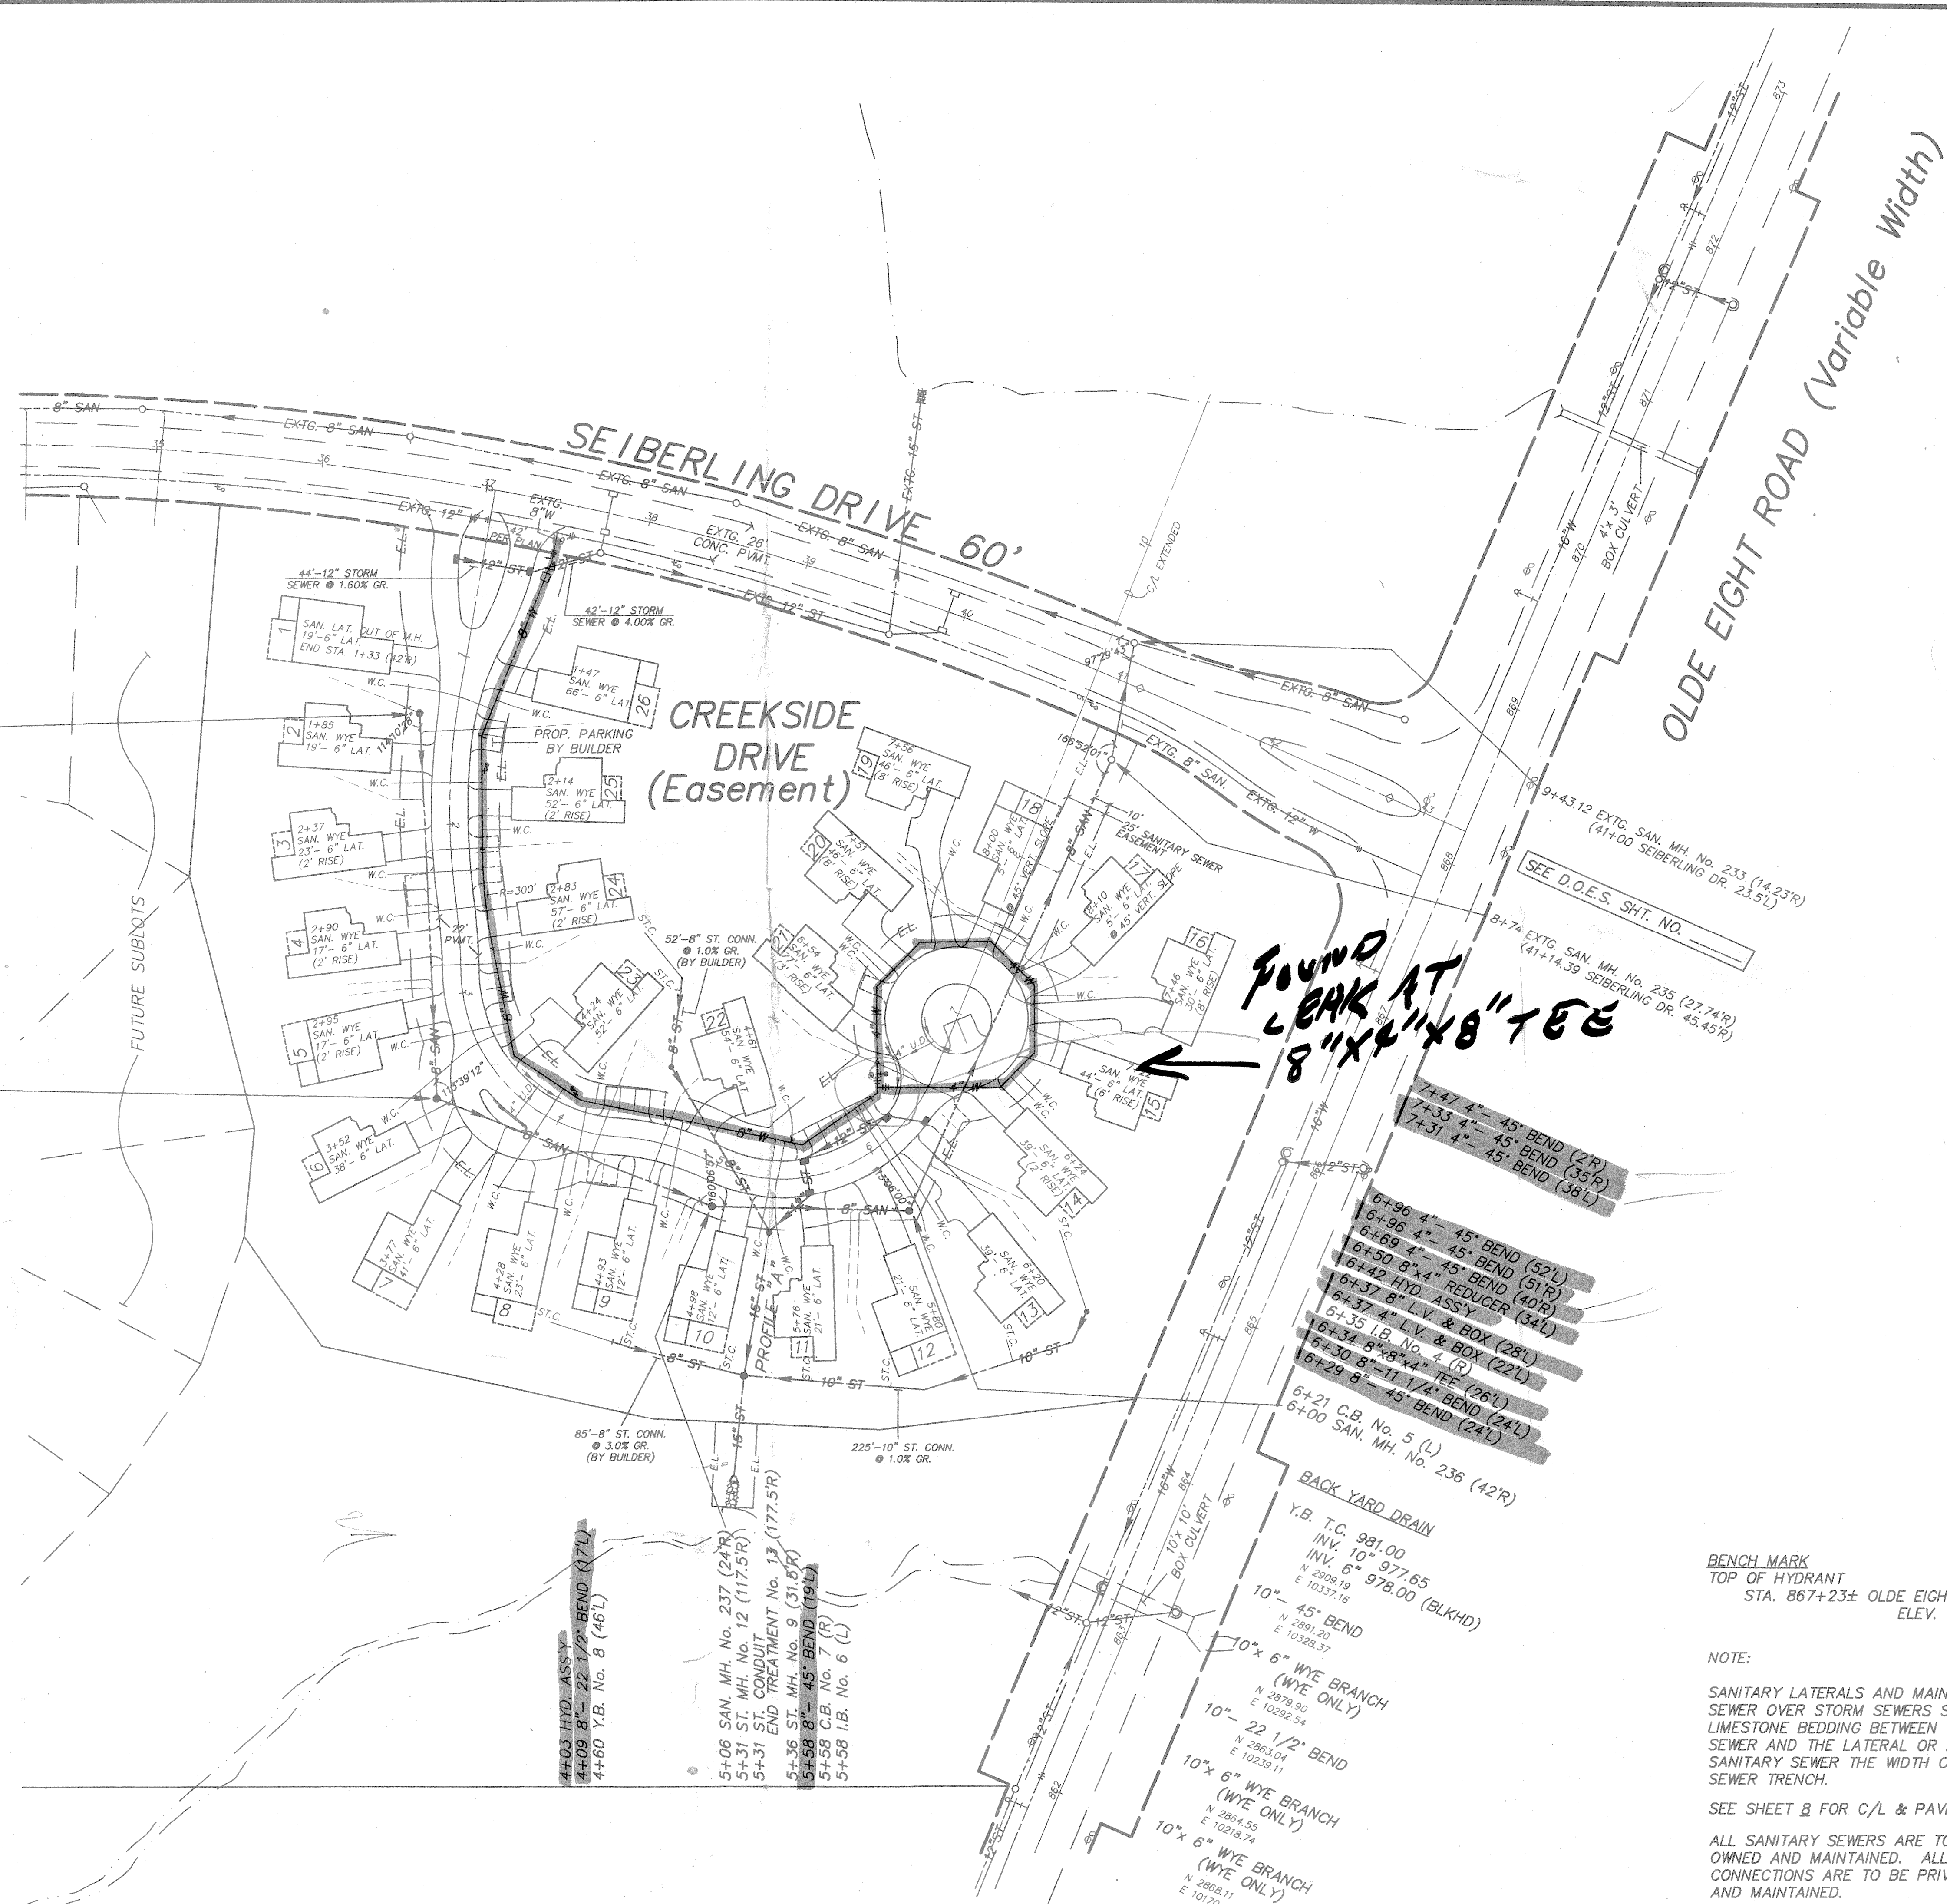

FOUND
LEAK AT
8"X4"X8" TEE

BENCH MARK
TOP OF HYDRANT
STA. 867+23± OLDE EIGHT ROAD
ELEV. 1001.18

NOTE:
SANITARY LATERALS AND MAINLINE SANITARY SEWER OVER STORM SEWERS SHALL HAVE LIMESTONE BEDDING BETWEEN THE STORM SEWER AND THE LATERAL OR MAINLINE SANITARY SEWER THE WIDTH OF THE STORM SEWER TRENCH.

SEE SHEET 8 FOR C/L & PAVEMENT GEOMETRY

ALL SANITARY SEWERS ARE TO BE PUBLICLY OWNED AND MAINTAINED. ALL SANITARY CONNECTIONS ARE TO BE PRIVATELY OWNED AND MAINTAINED.