


CURVE	RADIUS	ARC LENGTH	CHORD LENGTH	CHORD BEARING	DELTA ANGLE	TANGENT
C2	300.00'	392.70'	365.26'	S 59°15'03" E	75°00'00"	230.20'
C3	300.00'	151.26'	149.66'	S 82°18'24" E	28°53'18"	77.27'

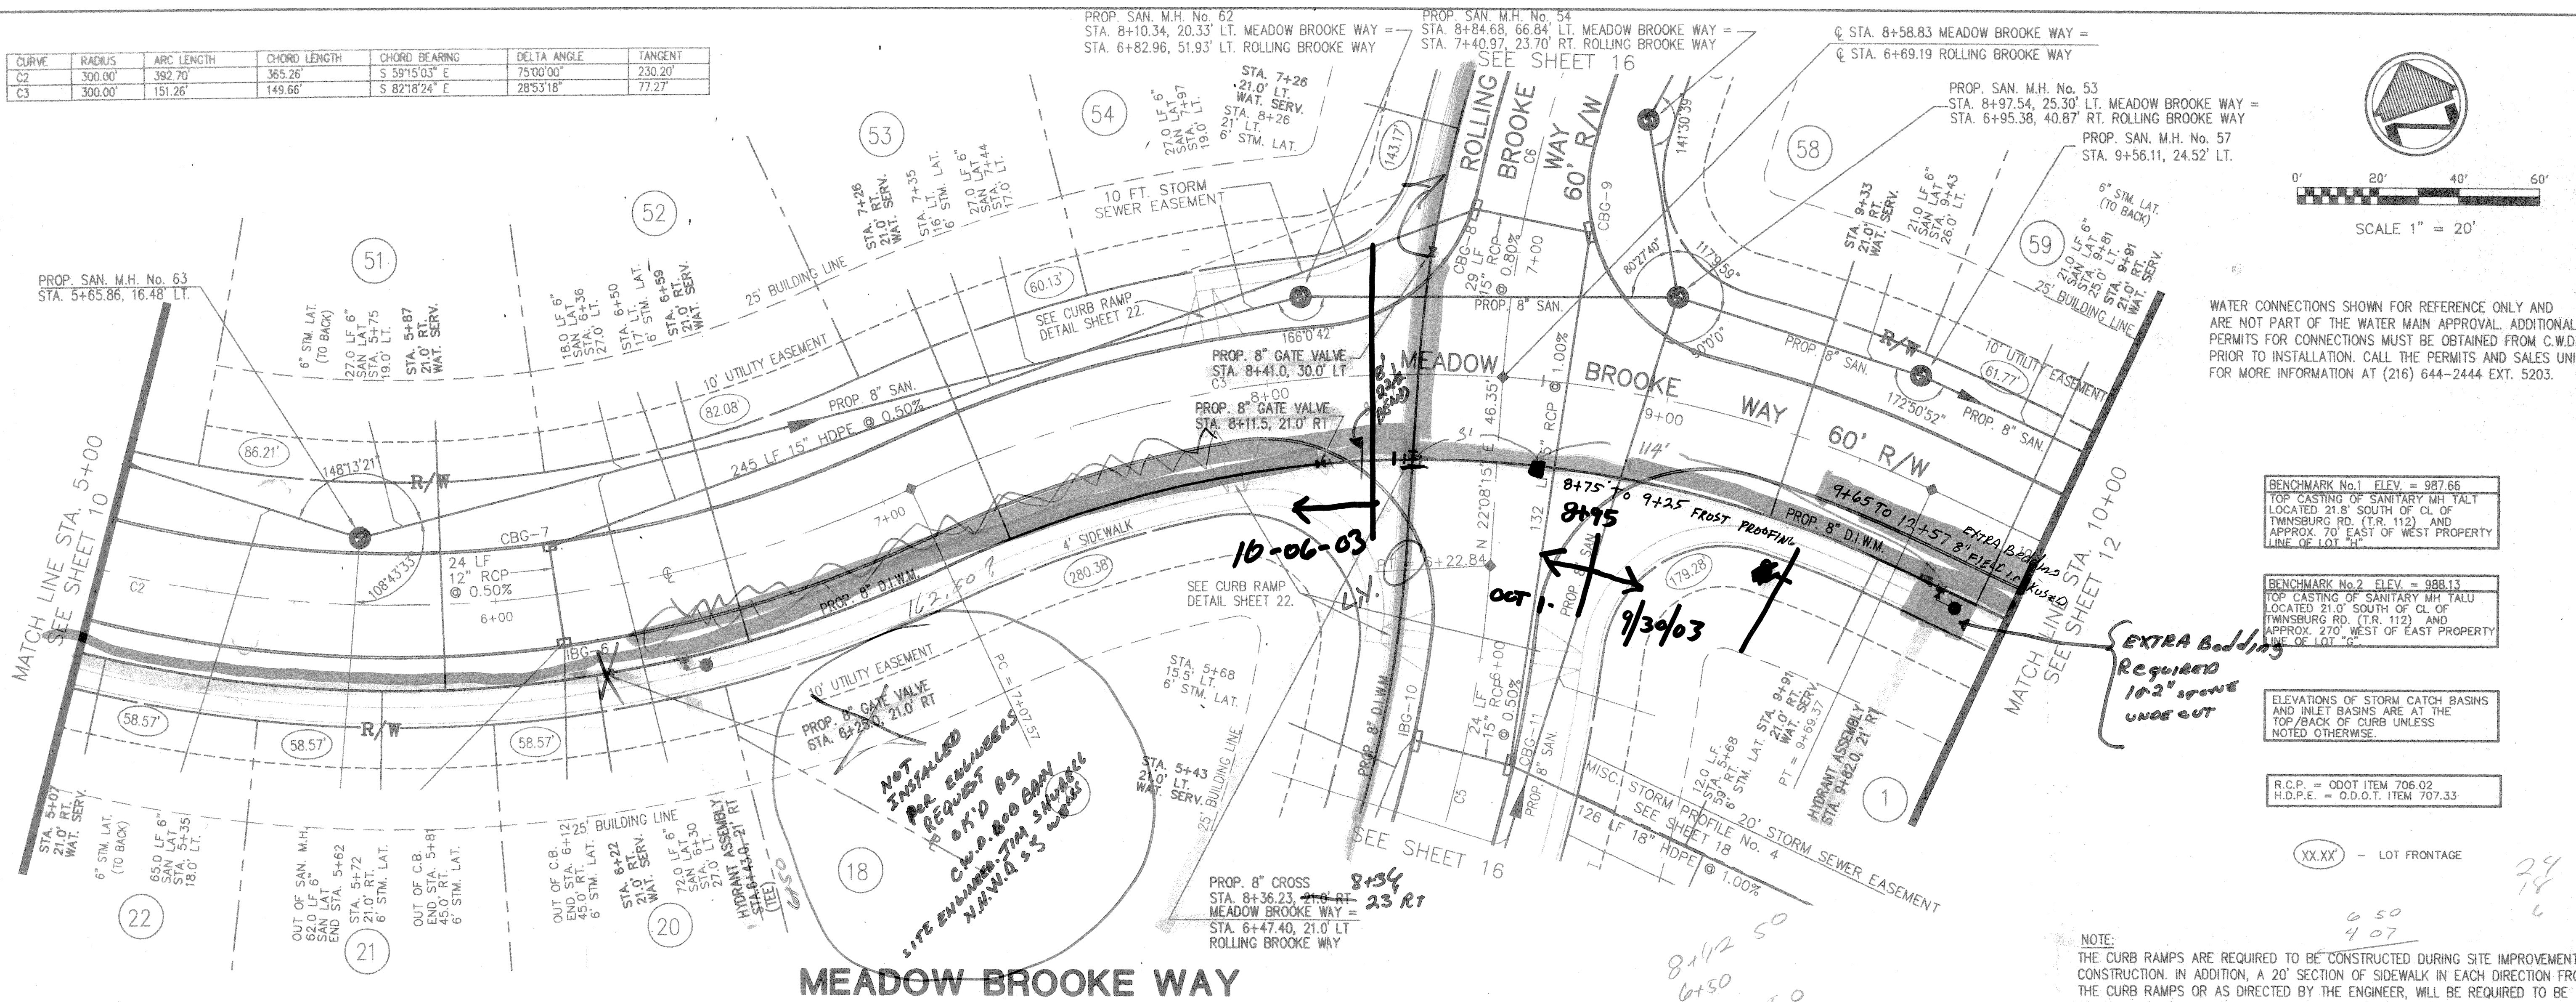

WATER CONNECTIONS SHOWN FOR REFERENCE ONLY AND ARE NOT PART OF THE WATER MAIN APPROVAL. ADDITIONAL PERMITS FOR CONNECTIONS MUST BE OBTAINED FROM C.W.D. PRIOR TO INSTALLATION. CALL THE PERMITS AND SALES UNIT FOR MORE INFORMATION AT (216) 644-2444 EXT. 5203.

BENCHMARK No.1 ELEV. = 987.66
TOP CASTING OF SANITARY MH TALL LOCATED 21.0' SOUTH OF CL OF TWINSBURG RD. (T.R. 112) AND APPROX. 70' EAST OF WEST PROPERTY LINE OF LOT "H"

BENCHMARK No.2 ELEV. = 988.13
TOP CASTING OF SANITARY MH TALL LOCATED 21.0' SOUTH OF CL OF TWINSBURG RD. (T.R. 112) AND APPROX. 270' WEST OF EAST PROPERTY LINE OF LOT "G"



ELEVATIONS OF STORM CATCH BASINS AND INLET BASINS ARE AT THE TOP/BACK OF CURB UNLESS NOTED OTHERWISE.

R.C.P. = ODOT ITEM 706.02
H.D.P.E. = O.D.O.T. ITEM 707.33

XX.XX' - LOT FRONTAGE

NOTE:
THE CURB RAMPS ARE REQUIRED TO BE CONSTRUCTED DURING SITE IMPROVEMENT CONSTRUCTION. IN ADDITION, A 20' SECTION OF SIDEWALK IN EACH DIRECTION FROM THE CURB RAMPS OR AS DIRECTED BY THE ENGINEER, WILL BE REQUIRED TO BE CONSTRUCTED DURING SITE IMPROVEMENT CONSTRUCTION.

MEADOW BROOKE WAY

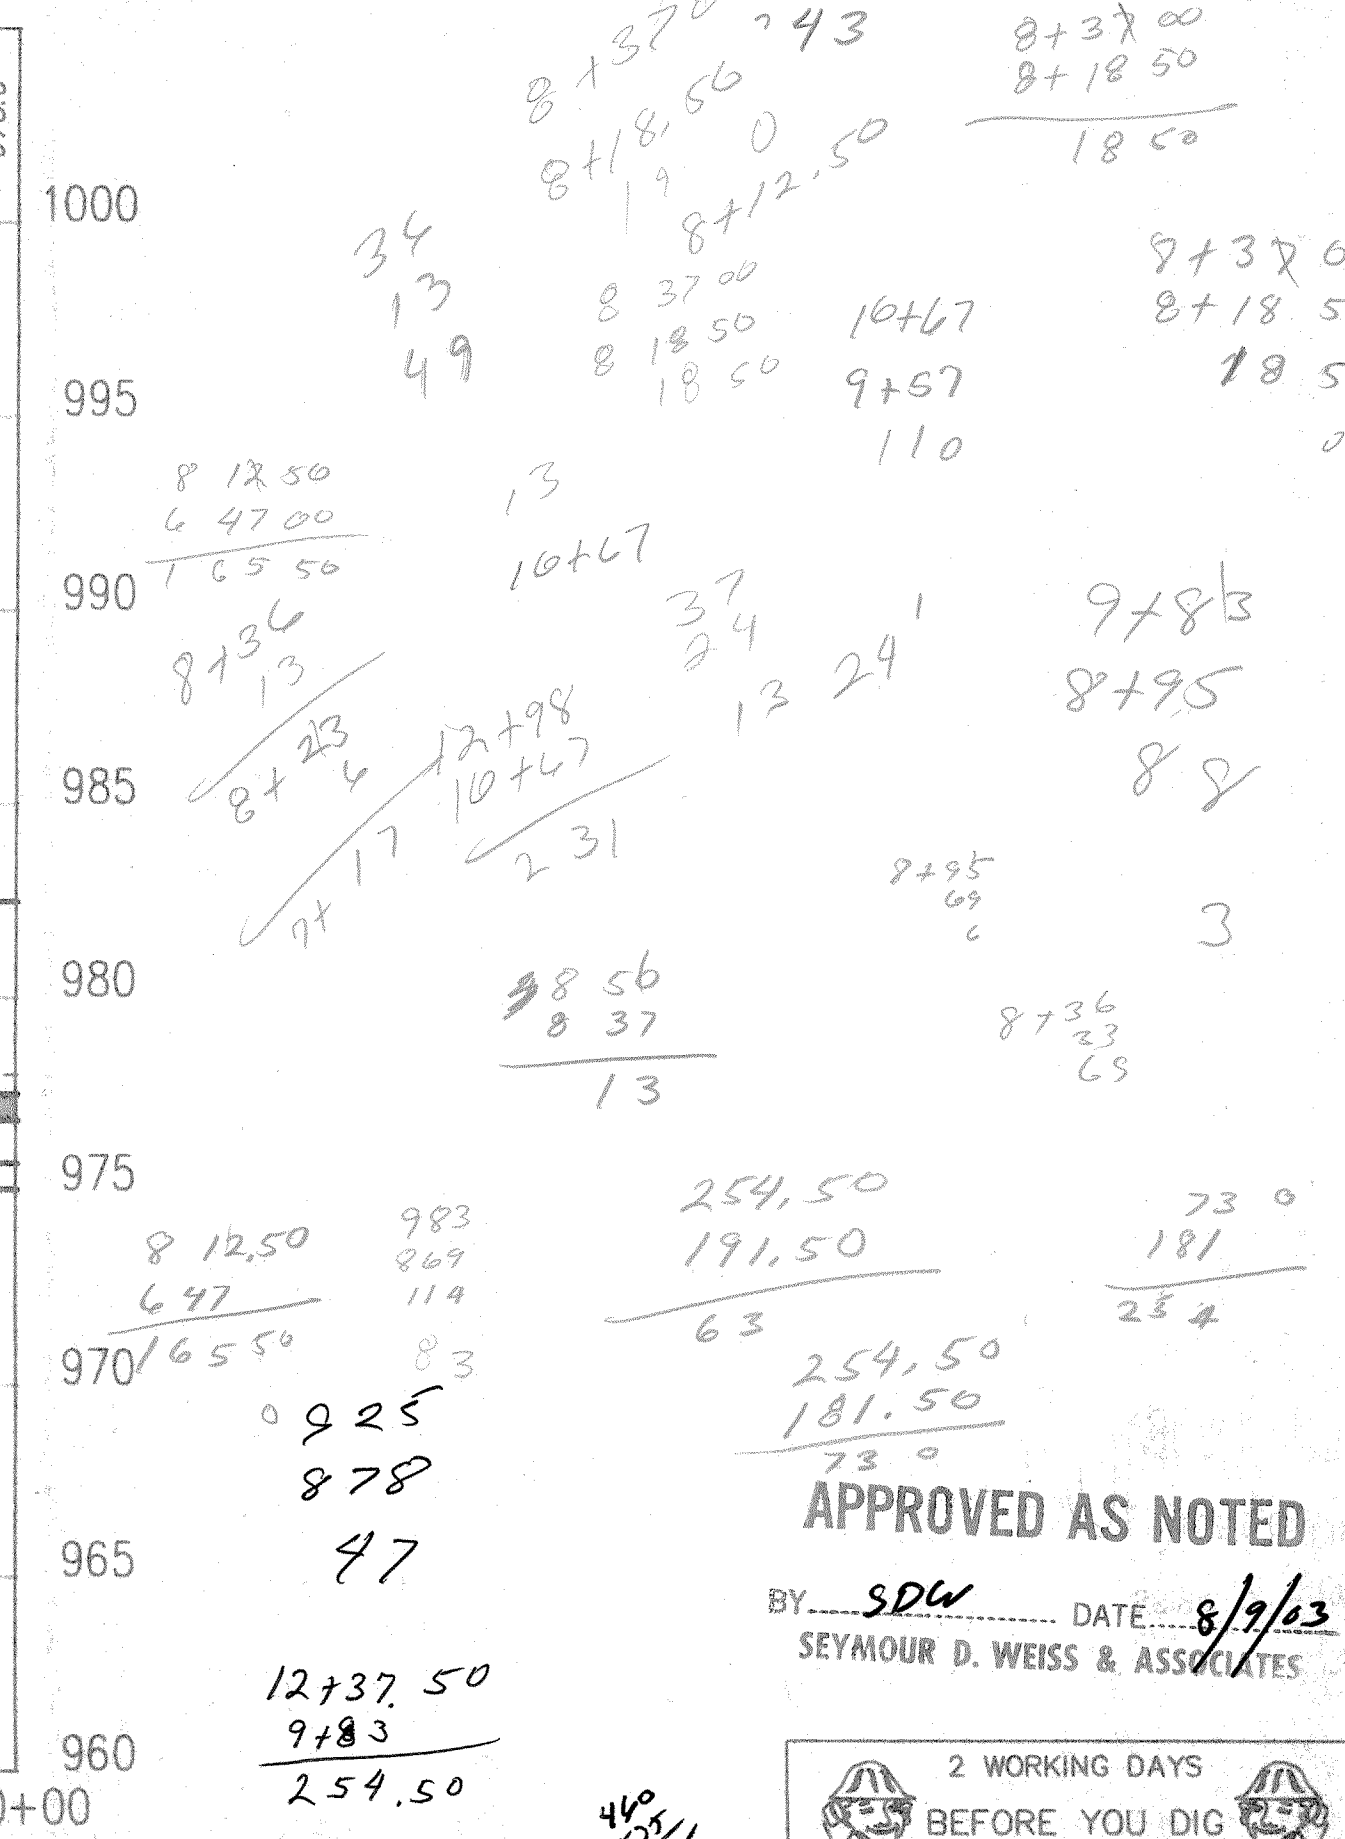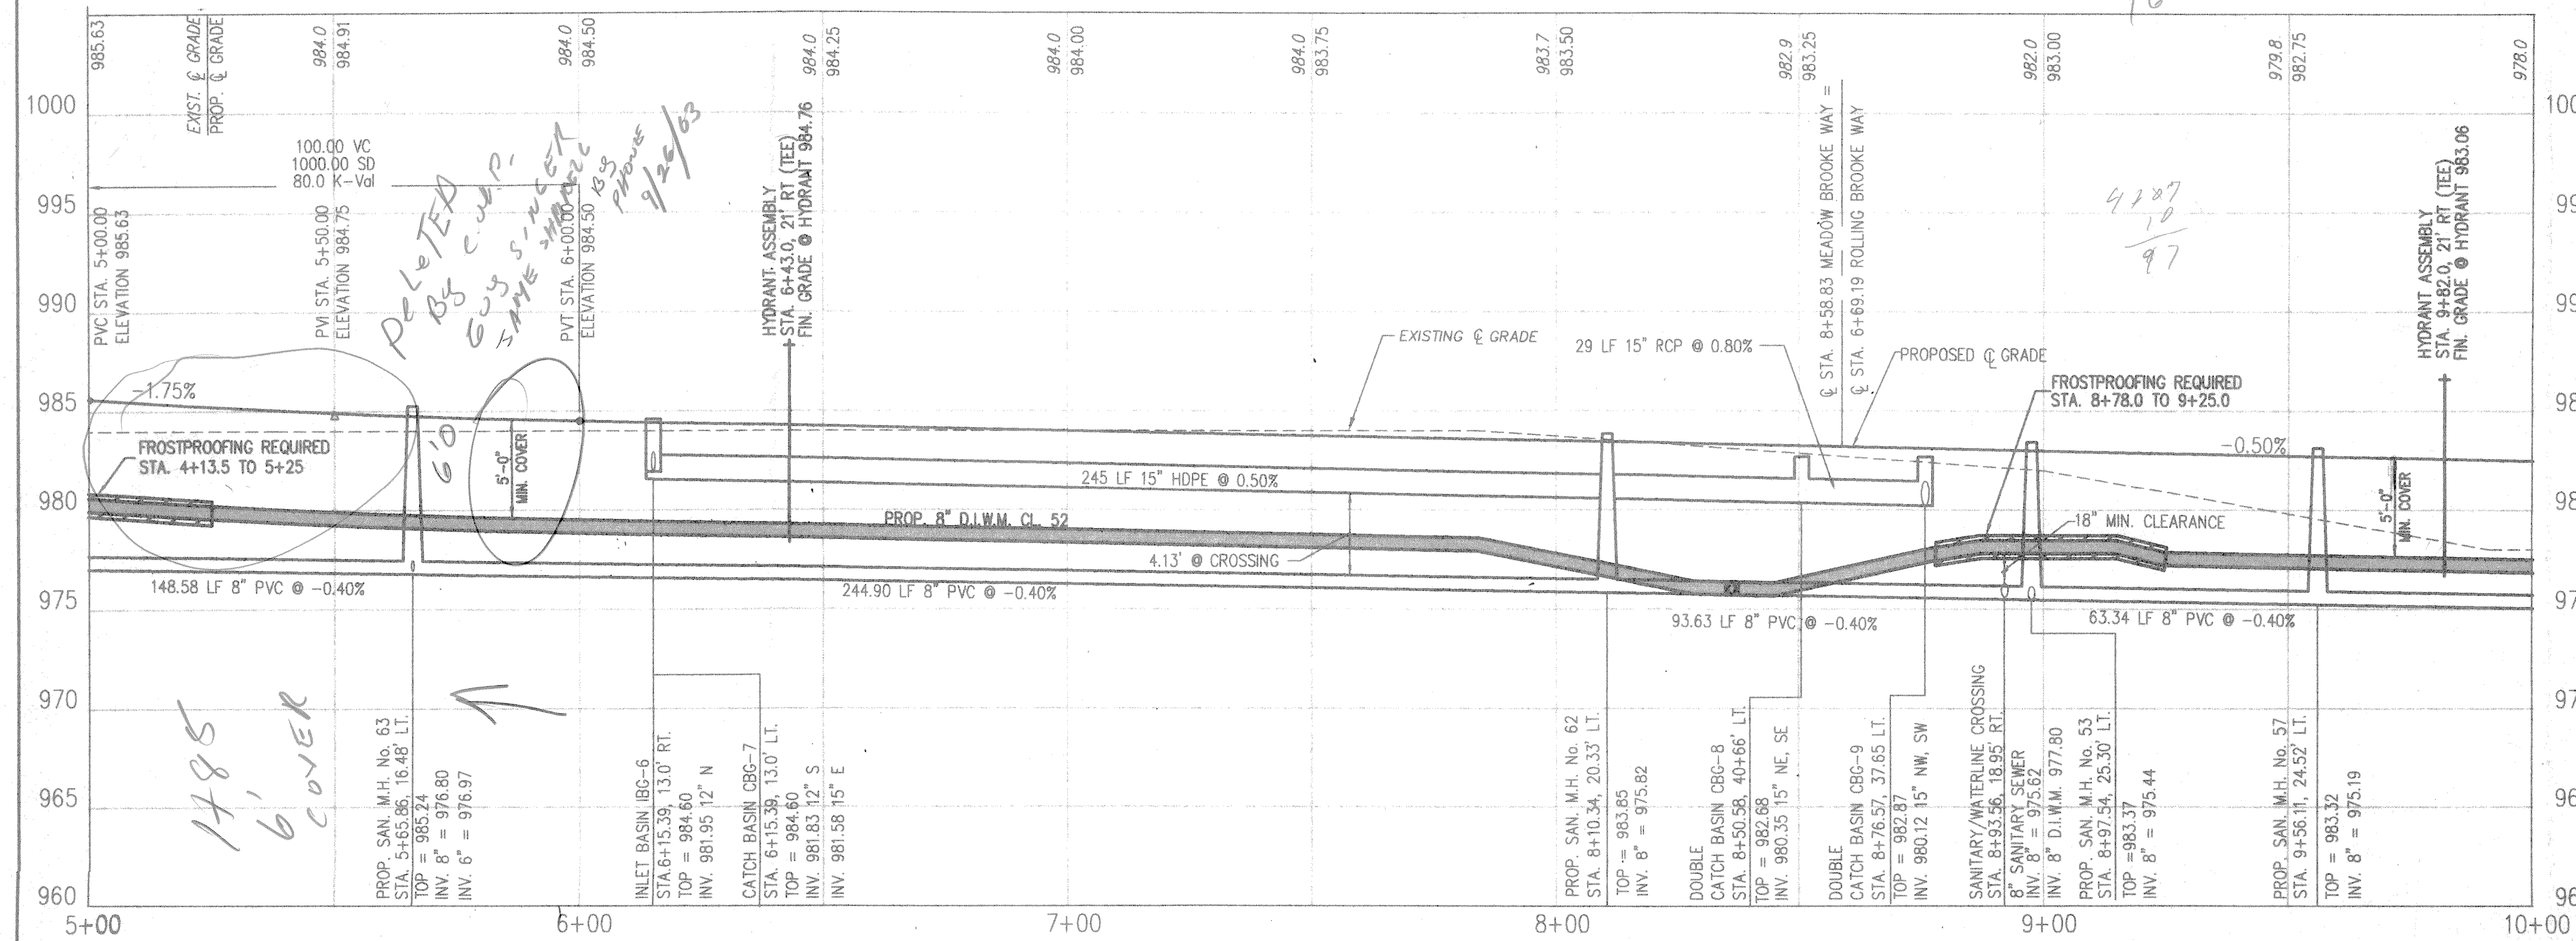

APPROVED AS NOTED

BY: SDW DATE: 8/9/03
SEYMOUR D. WEISS & ASSOCIATES

2 WORKING DAYS
BEFORE YOU DIG
CALL TOLL FREE: 800-362-2764

OHIO UTILITIES PROTECTION SERVICE

MEADOW BROOKE WAY
STA. 5+00 - STA. 10+00


ROLLING BROOKE SUBDIVISION
PLAN AND PROFILE

20011290


CAMPBELL & ASSOCIATES, INC.
Engineering - Surveying
1923 Bailey Rd Suite A Cuyahoga Falls, Ohio 44221 (330) 945-4117

11
25

MATCHLINE STA. 10+00
SEE SHEET 11

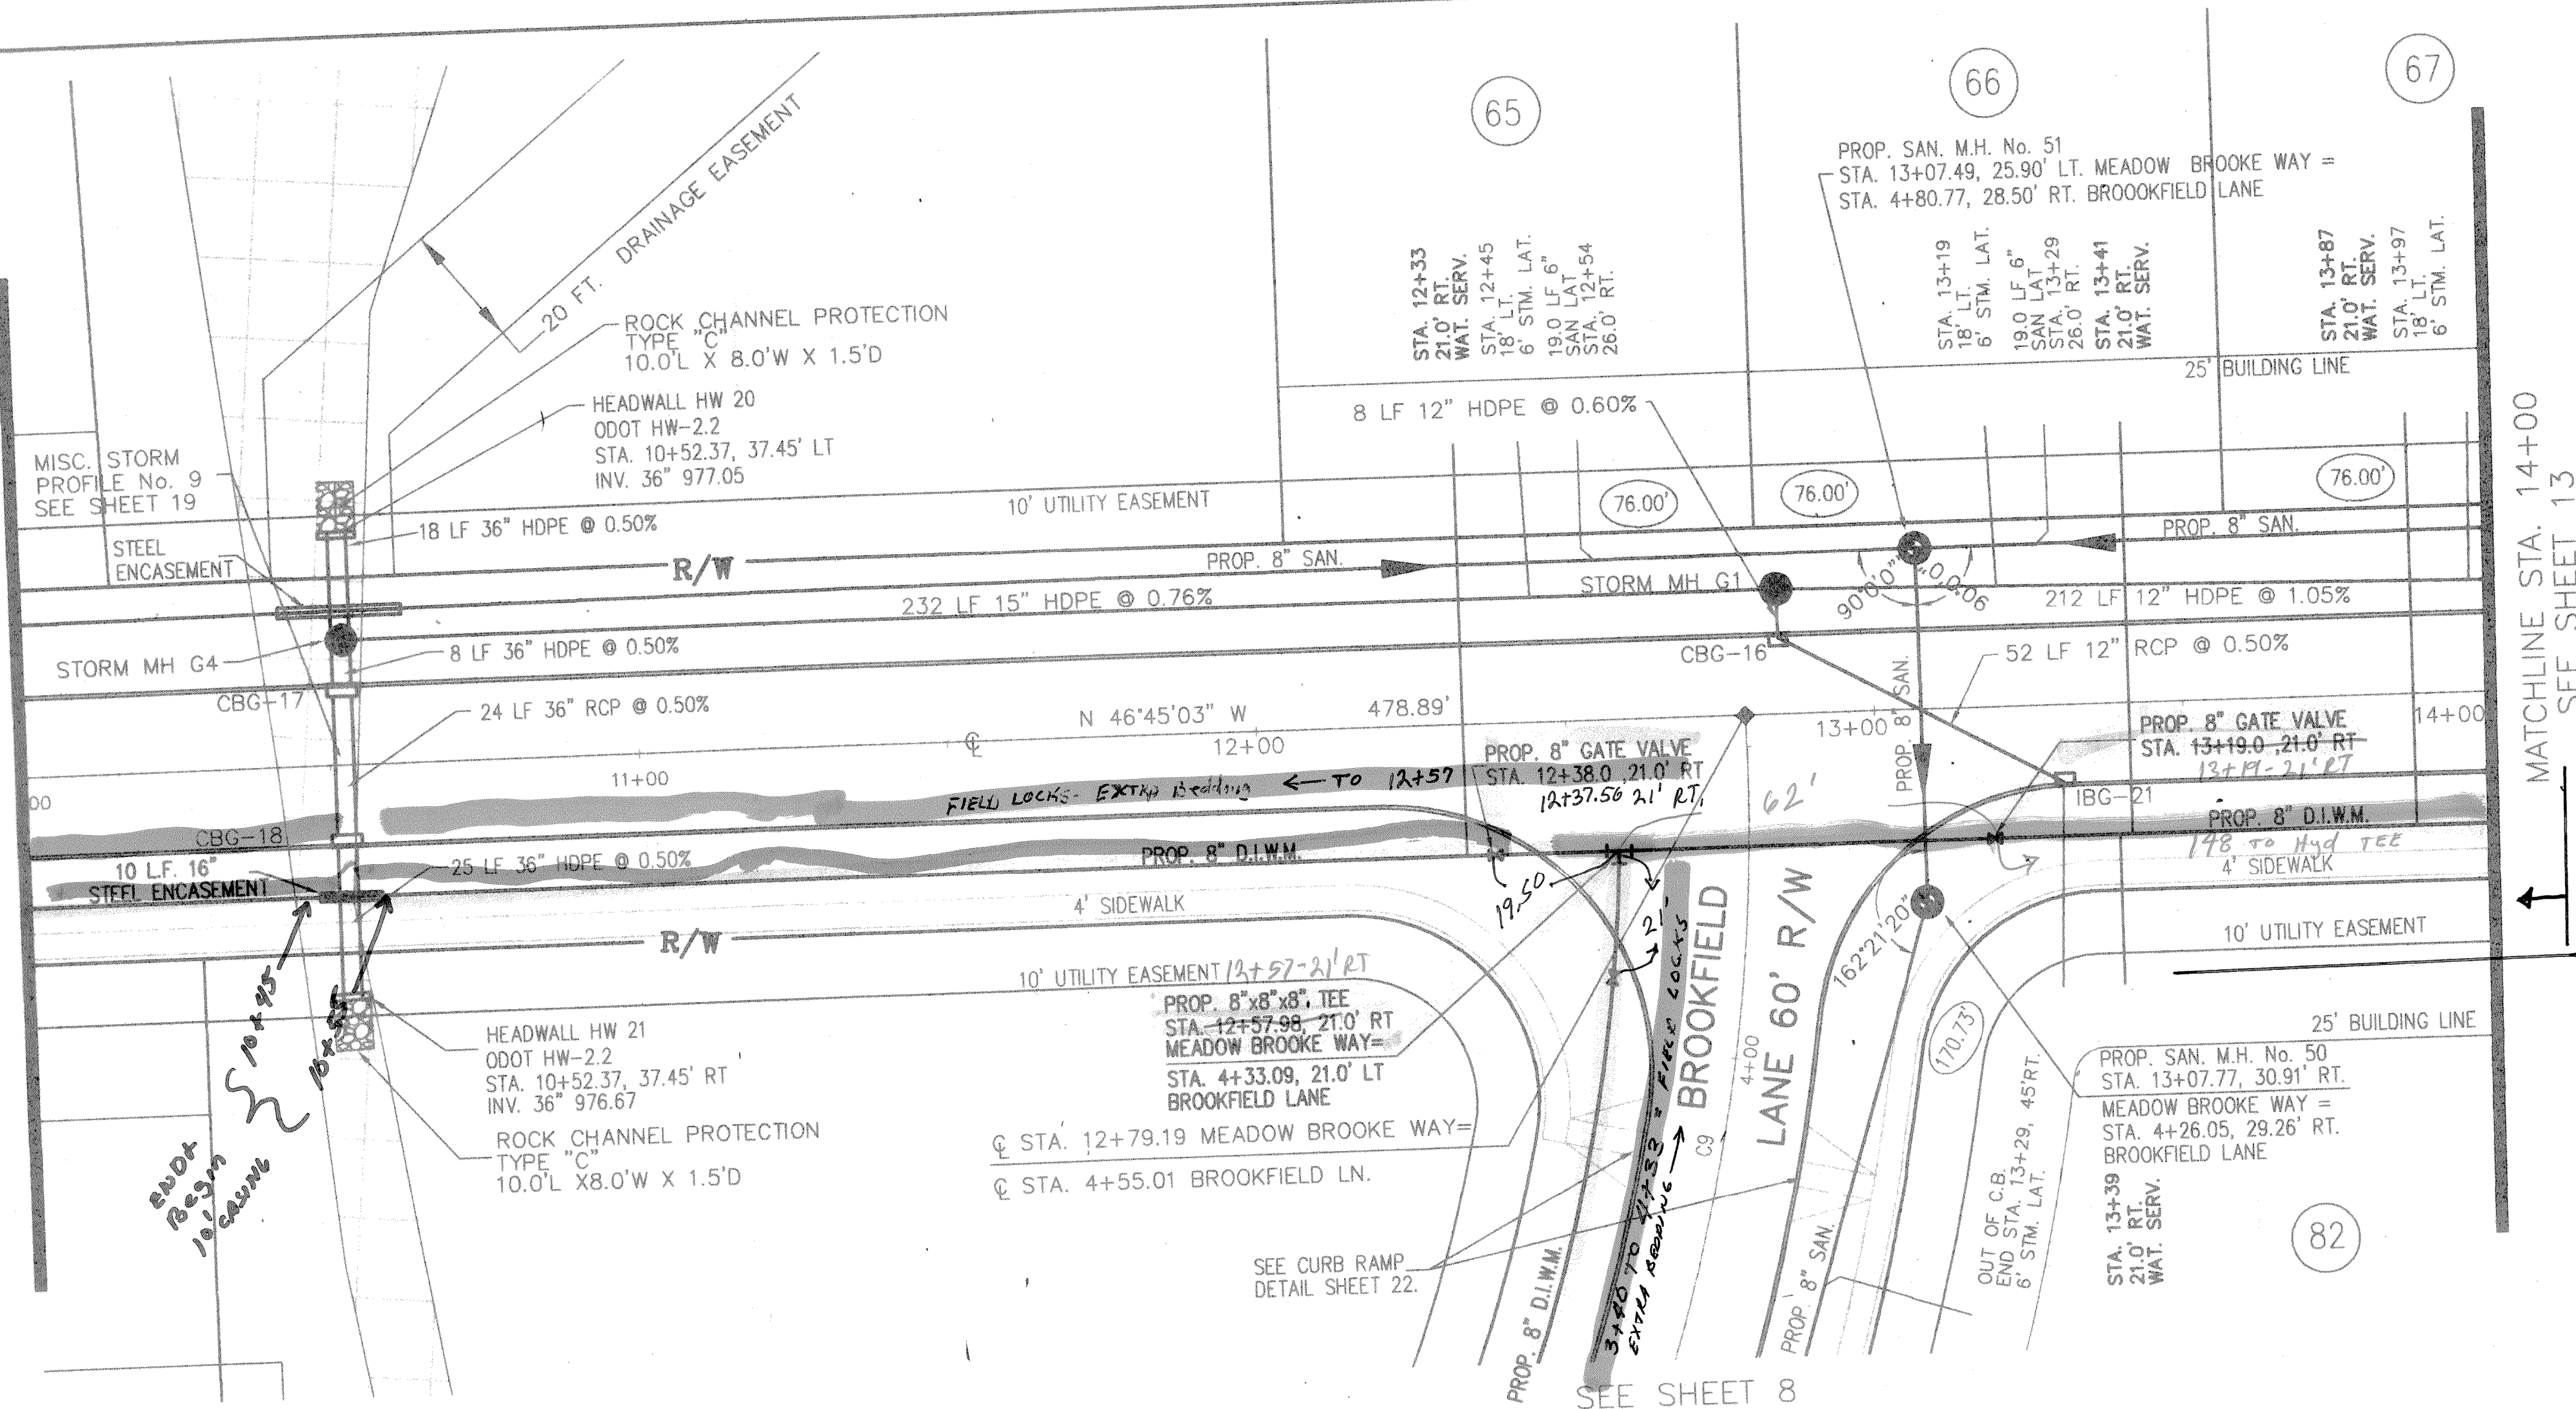

WATER CONNECTIONS SHOWN FOR REFERENCE ONLY AND ARE NOT PART OF THE WATER MAIN APPROVAL. ADDITIONAL PERMITS FOR CONNECTIONS MUST BE OBTAINED FROM C.W.D. PRIOR TO INSTALLATION. CALL THE PERMITS AND SALES UNIT FOR MORE INFORMATION AT (216) 644-2444 EXT. 5203.

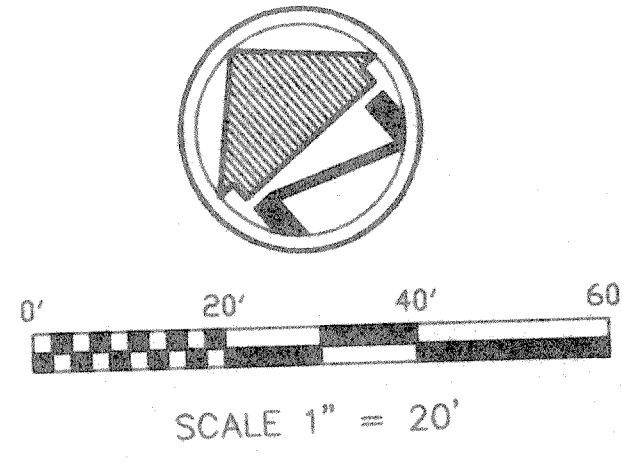

BENCHMARK No.1 ELEV. = 987.66
TOP CASTING OF SANITARY MH TALT
LOCATED 21.8' SOUTH OF CL OF
TWINSBURG RD. (T.R. 112) AND
APPROX. 70' EAST OF WEST PROPERTY
LINE OF LOT "H"

BENCHMARK No.2 ELEV. = 988.13
TOP CASTING OF SANITARY MH TALT
LOCATED 21.0' SOUTH OF CL OF
TWINSBURG RD. (T.R. 112) AND
APPROX. 270' WEST OF EAST PROPERTY
LINE OF LOT "G"

ELEVATIONS OF STORM CATCH BASINS
AND INLET BASINS ARE AT THE
TOP/BACK OF CURB UNLESS
NOTED OTHERWISE.

R.C.P. = ODOT ITEM 706.02
H.D.P.E. = O.D.O.T. ITEM 707.33

XX.XX' - LOT FRONTAGE


W.M.
WORK
9-25-03

1319
1253
62

NOTE:
THE CURB RAMPS ARE REQUIRED TO BE CONSTRUCTED DURING SITE IMPROVEMENT CONSTRUCTION. IN ADDITION, A 20' SECTION OF SIDEWALK IN EACH DIRECTION FROM THE CURB RAMPS OR AS DIRECTED BY THE ENGINEER, WILL BE REQUIRED TO BE CONSTRUCTED DURING SITE IMPROVEMENT CONSTRUCTION.

MEADOW BROOKE WAY

62 1/2

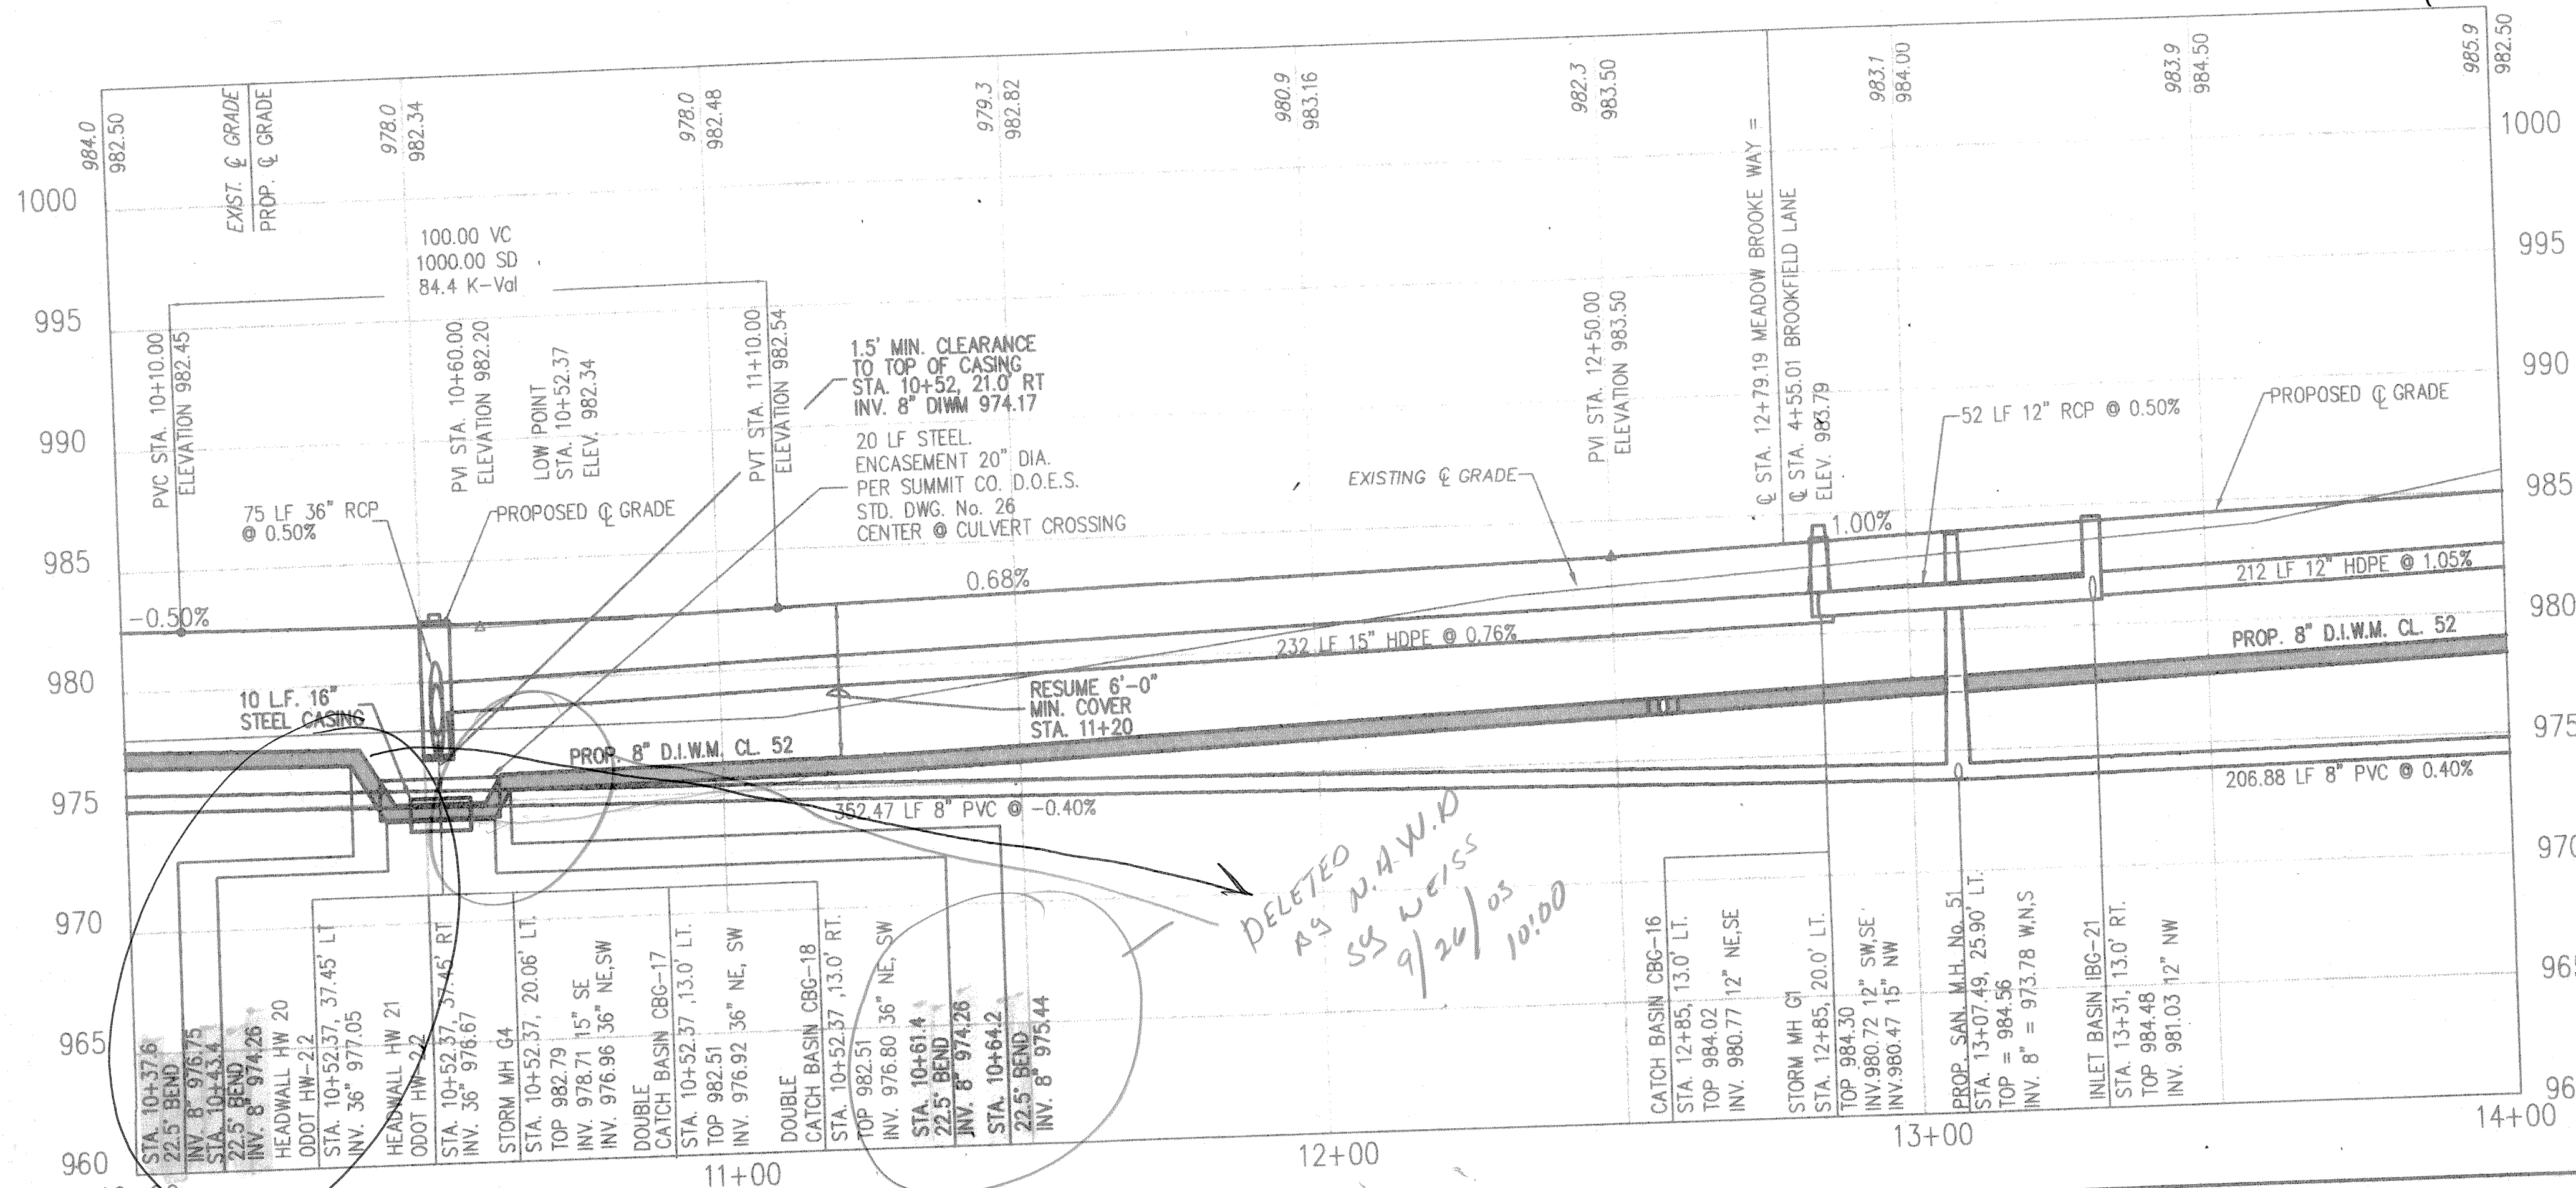

APPROVED AS NOTED
BY SPW DATE 8/19/03
SEYMOUR D. WEISS & ASSOCIATES

2 WORKING DAYS
BEFORE YOU DIG
CALL TOLL FREE: 800-362-2764


MEADOW BROOKE WAY
STA. 10+00 - STA. 15+00

BY	DATE	NO.	REVISION
CTB	2/18/03	1	REV. AS PER SUMMIT CO. ENGINEER AND D.O.E.S.
CTB	4/25/03	2	REV. AS PER SUMMIT CO. ENGINEER AND D.O.E.S.
CTB	8/24/03	3	REV. PER SUMMIT CO. ENG., CLEV. WATER & N.H.W.D.

PROJECT NUMBER: 20011290


CAMPBELL & ASSOCIATES, INC.
Engineering
1923 Bailey Rd Suite A Cuyahoga Falls, Ohio 44221 (330) 945-4117

12 25

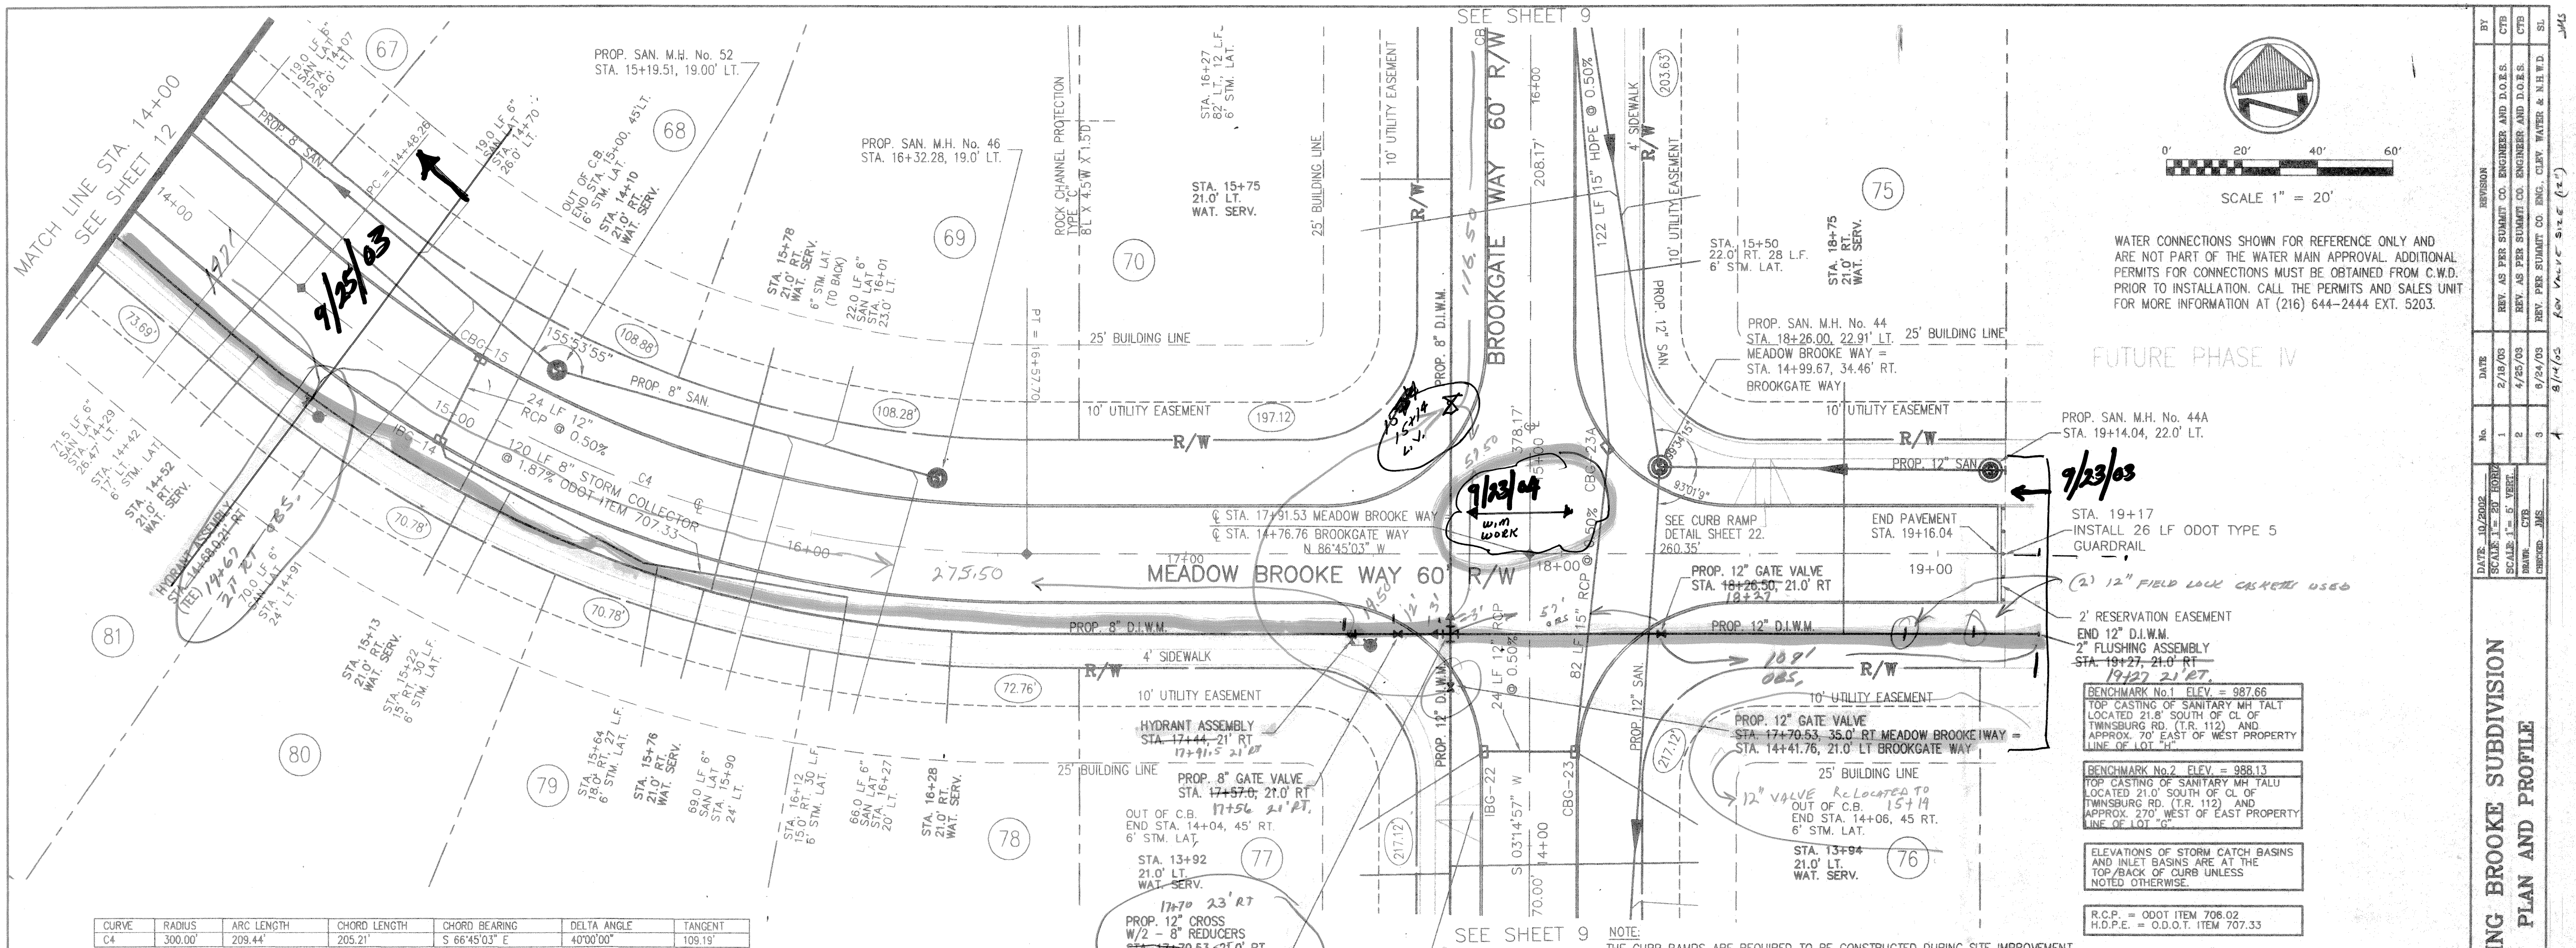

CURVE	RADIUS	ARC LENGTH	CHORD LENGTH	CHORD BEARING	DELTA ANGLE	TANGENT
C4	300.00'	209.44'	205.21'	S 66°45'03" E	40°00'00"	109.19'

MEADOW BROOKE WAY

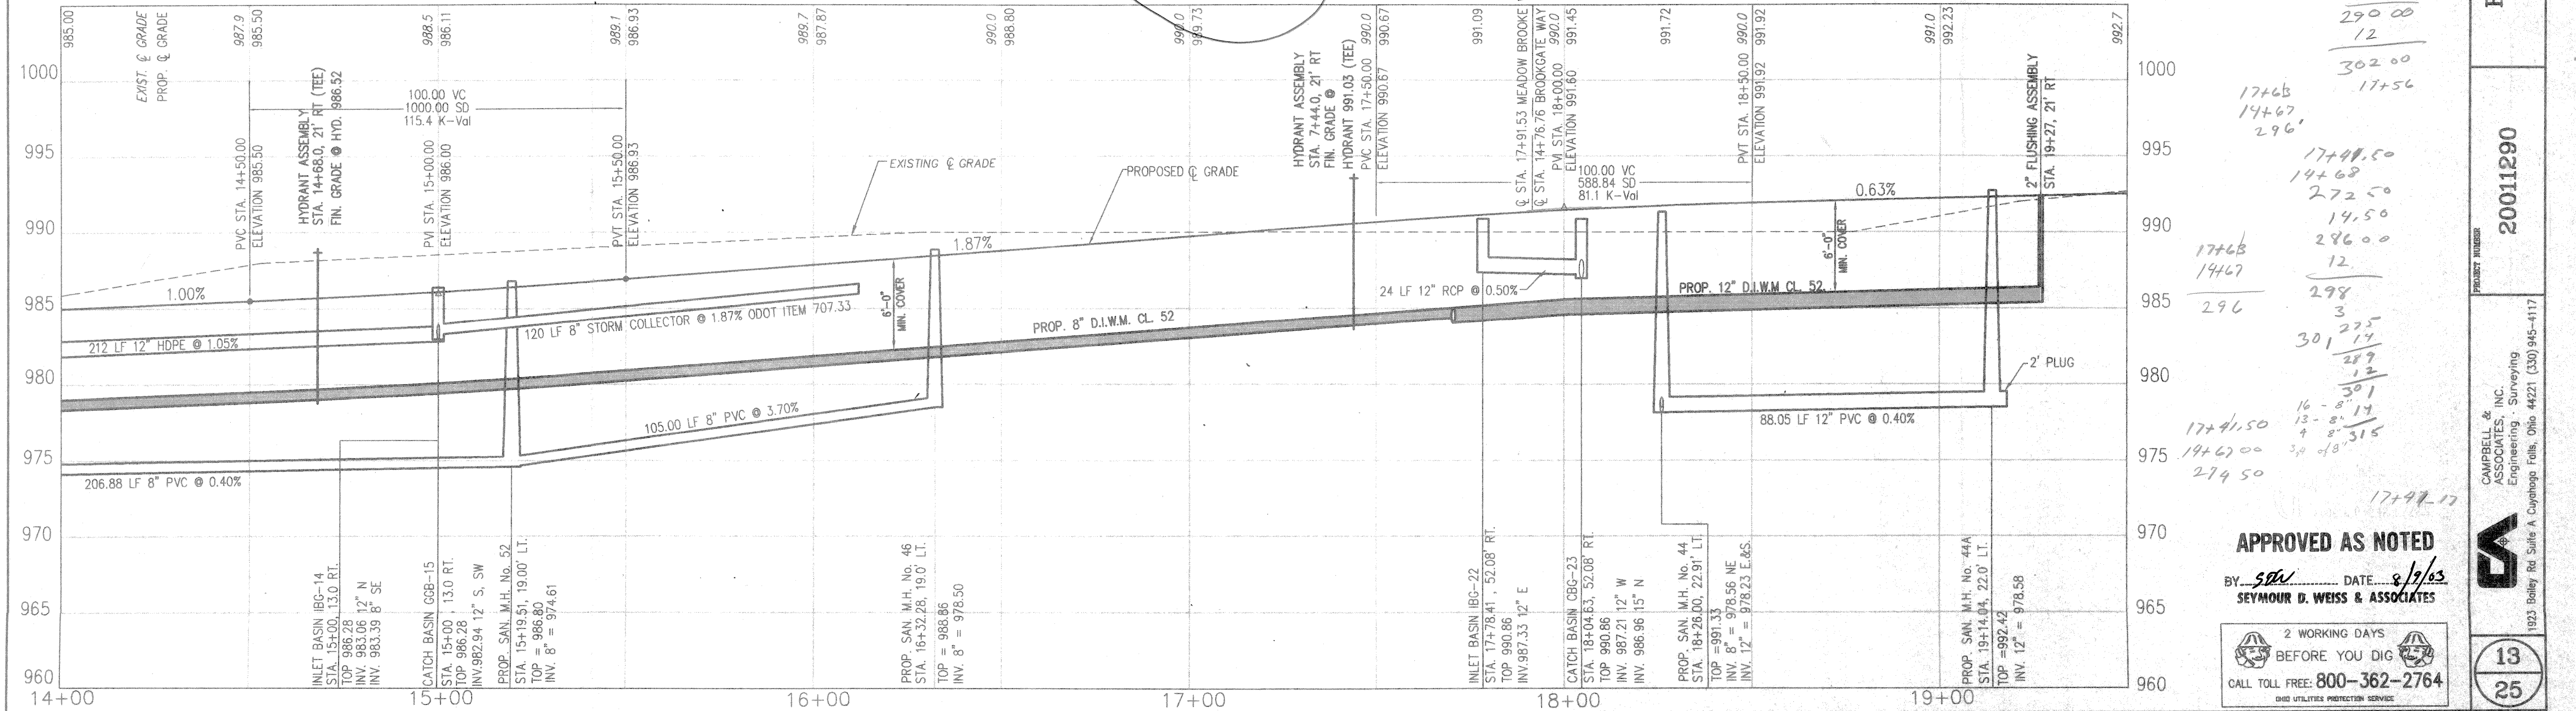

APPROVED AS NOTED
 BY: *SDW* DATE: *8/9/03*
 SEYMOUR D. WEISS & ASSOCIATES
 2 WORKING DAYS BEFORE YOU DIG
 CALL TOLL FREE: 800-362-2764
 Ohio Utilities Protection Service

ROLLING BROOKE SUBDIVISION
PLAN AND PROFILE
20011290
 PREPARED BY: CAMPBELL & ASSOCIATES, INC.
 1923 Bailey Rd Suite A Cuyahoga Falls, Ohio 44221 (330) 945-1177
 DATE: 10/20/02
 SCALE: 1" = 20' HORIZ.
 SCALE: 1" = 5' VERT.
 DRAWN: CTR
 CHECKED: JMS
 NO. 1
 DATE: 2/15/03
 REV. AS PER SUMMIT CO. ENGINEER AND D.O.E.S.
 CTS
 NO. 2
 DATE: 4/25/03
 REV. AS PER SUMMIT CO. ENGINEER AND D.O.E.S.
 CTS
 NO. 3
 DATE: 8/24/03
 REV. PER SUMMIT CO. ENG. CLEV. WATER & N.H.W.D.
 SL
 8/14/03
 Rev. Value Size (4x5)