


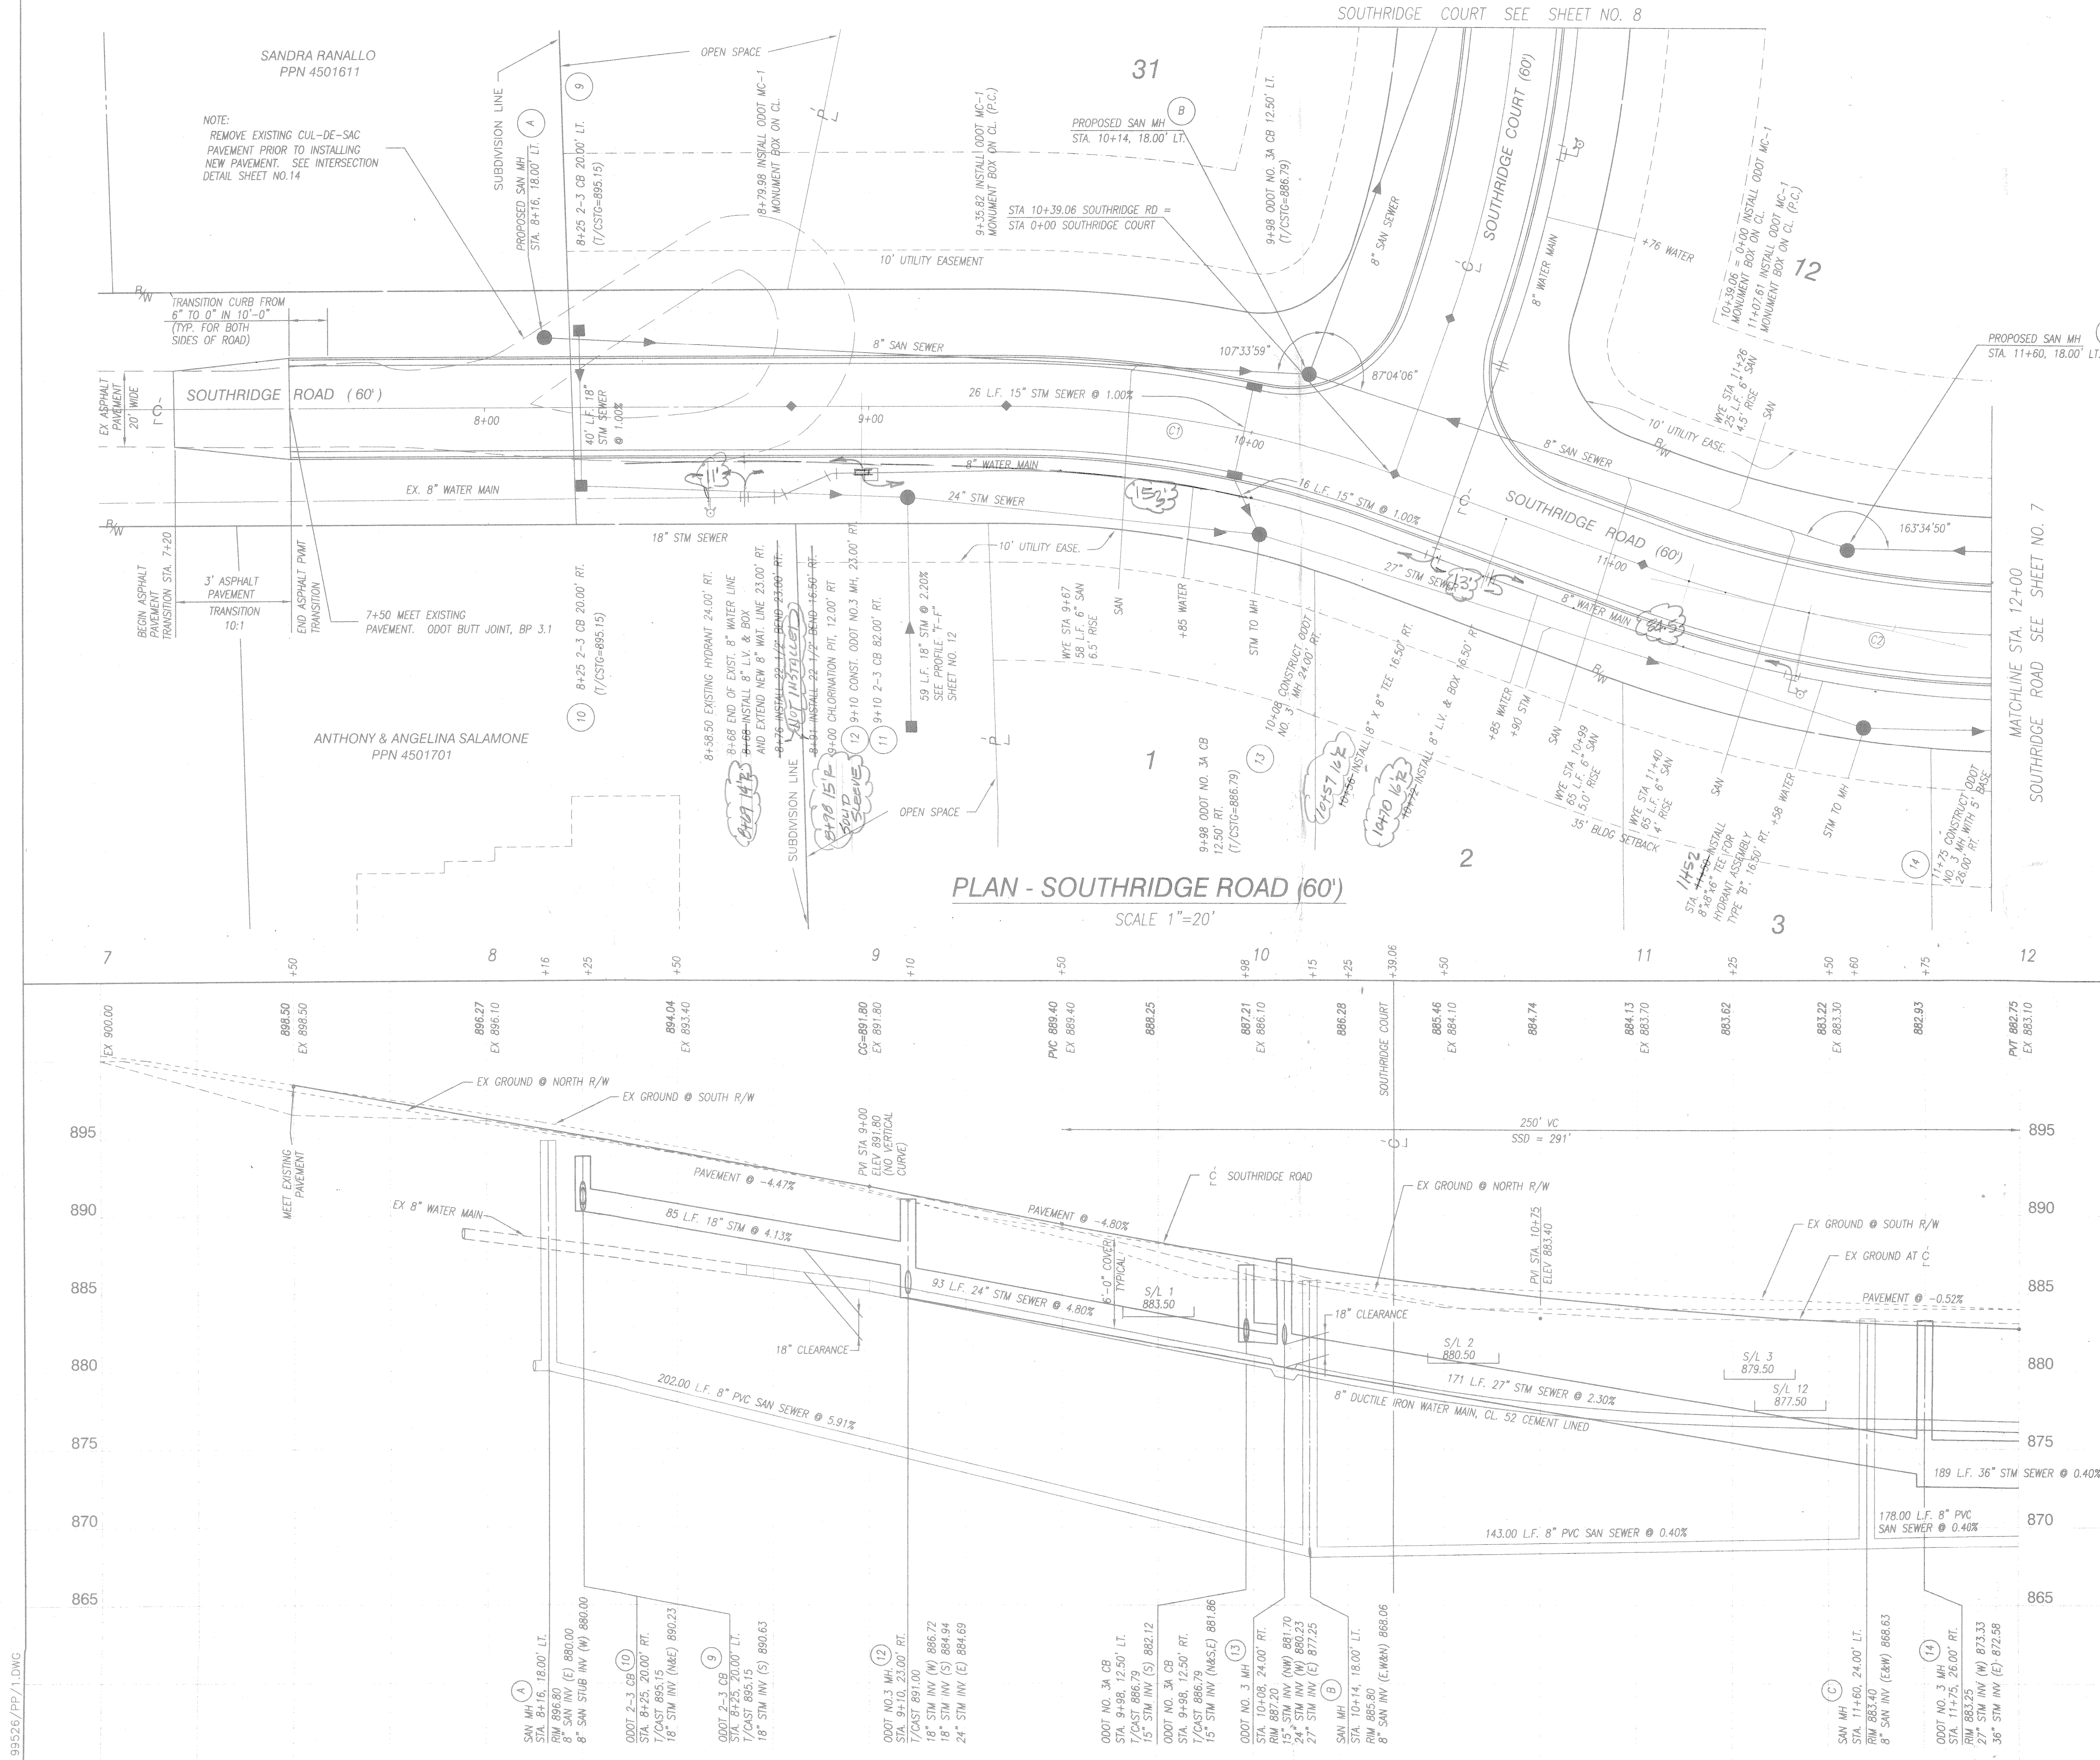


BENCHMARK
TOP NUT OF HYDRANT ON SOUTH SIDE OF
SOUTHRIDGE ROAD AT STA. 8+58.50
ELEVATION 895.17

CURVE DATA

(C1)
R=300.00'
Δ=19°43'07"
A=103.25'
T=52.14'
C=102.74'
BRG=S 79°23'26" E
PC=9+35.82
PI=9+87.96
PT=10+39.06

(C2)
R=300.00'
Δ=20°02'35"
A=104.95'
T=53.01'
C=104.41'
BRG=S 79°33'10" E
PC=11+07.61
PI=11+60.62
PT=12+12.56

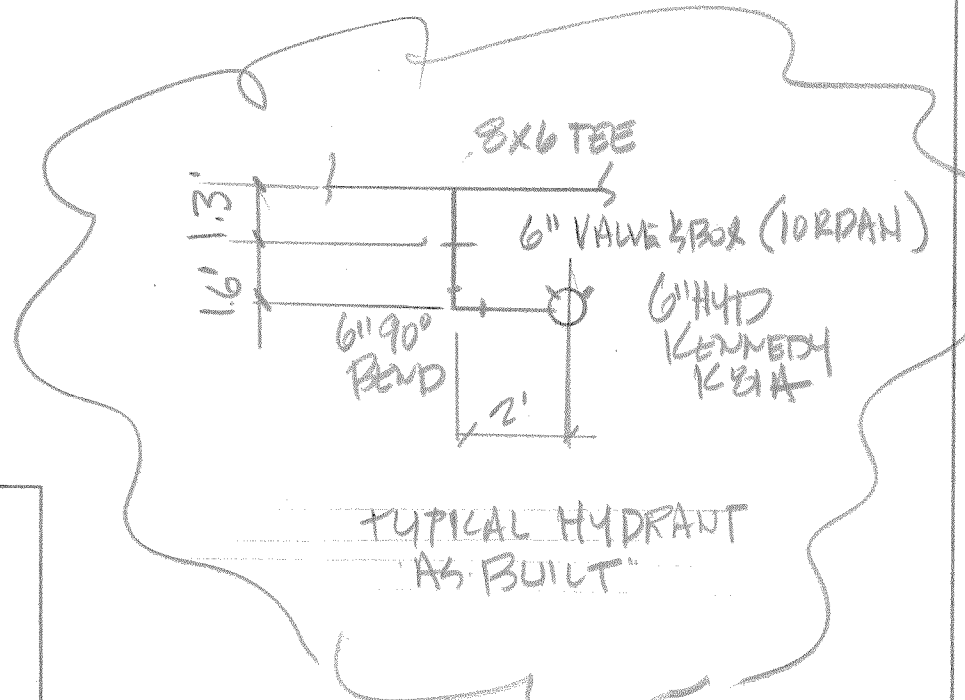

CHAGRIN VALLEY ENGR.
SCAN DATE: 7/16/99
SCAN FILE: 7/16/99
JOB#: 99-526
(SHEET 6 OF 7)

BRAMHALL
ENGINEERING AND SURVEYING CO., INC.
37307 HARVEST DRIVE AVON, OHIO 44011
(440) 934 - 7878 (440) 934 - 7879 FAX

**SOUTHRIDGE ESTATES
CLUSTER DEVELOPMENT**

**SOUTHRIDGE ROAD
PLAN & PROFILE**

SCALE: 1" = 20'

DATE: JUNE 1999

PROJECT NO: 99-526

SHEET NO: 6

DRAWN BY: JCS

CHECKED BY: CLH


REVISIONS:

NO.	DATE	DESCRIPTION
1	7/16/99	PER SUMMIT COUNTY ENGINEER'S COMMENTS DATED 7/16/99
2	7/20/99	PER CLEVELAND WATER DEPT COMMENTS DATED 7/16/99
3	8/12/99	PER D.O.E.S. COMMENTS


AS BUILT MEASUREMENTS W/ 12-2-99 FILE NO 9906-592-1

BRAMHALL
ENGINEERING AND SURVEYING CO., INC.
37307 HARVEST DRIVE AVON, OHIO 44011
(440) 934 - 7878 (440) 934 - 7879 FAX

**SOUTHRIDGE ESTATES
CLUSTER DEVELOPMENT
SOUTHRIDGE ROAD
PLAN & PROFILE**

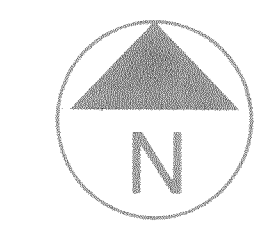

SCALE: 1" = 20'	
DATE: JUNE 1999	
PROJECT NO: 99-526	
SHEET NO: 7	
DRAW BY: JCS	
CHECKED BY: CLH	
REVISIONS	
PER SUMMIT COUNTY ENGINEER'S	
COMMENTS DATED 7/16/99	
PER D.O.E.S. COMMENTS	
DATED 7/20/99	
PER CLEVELAND WATER DEPT	
COMMENTS DATED 7/16/99	
PER D.O.E.S. COMMENTS	
DATED 8/12/99	

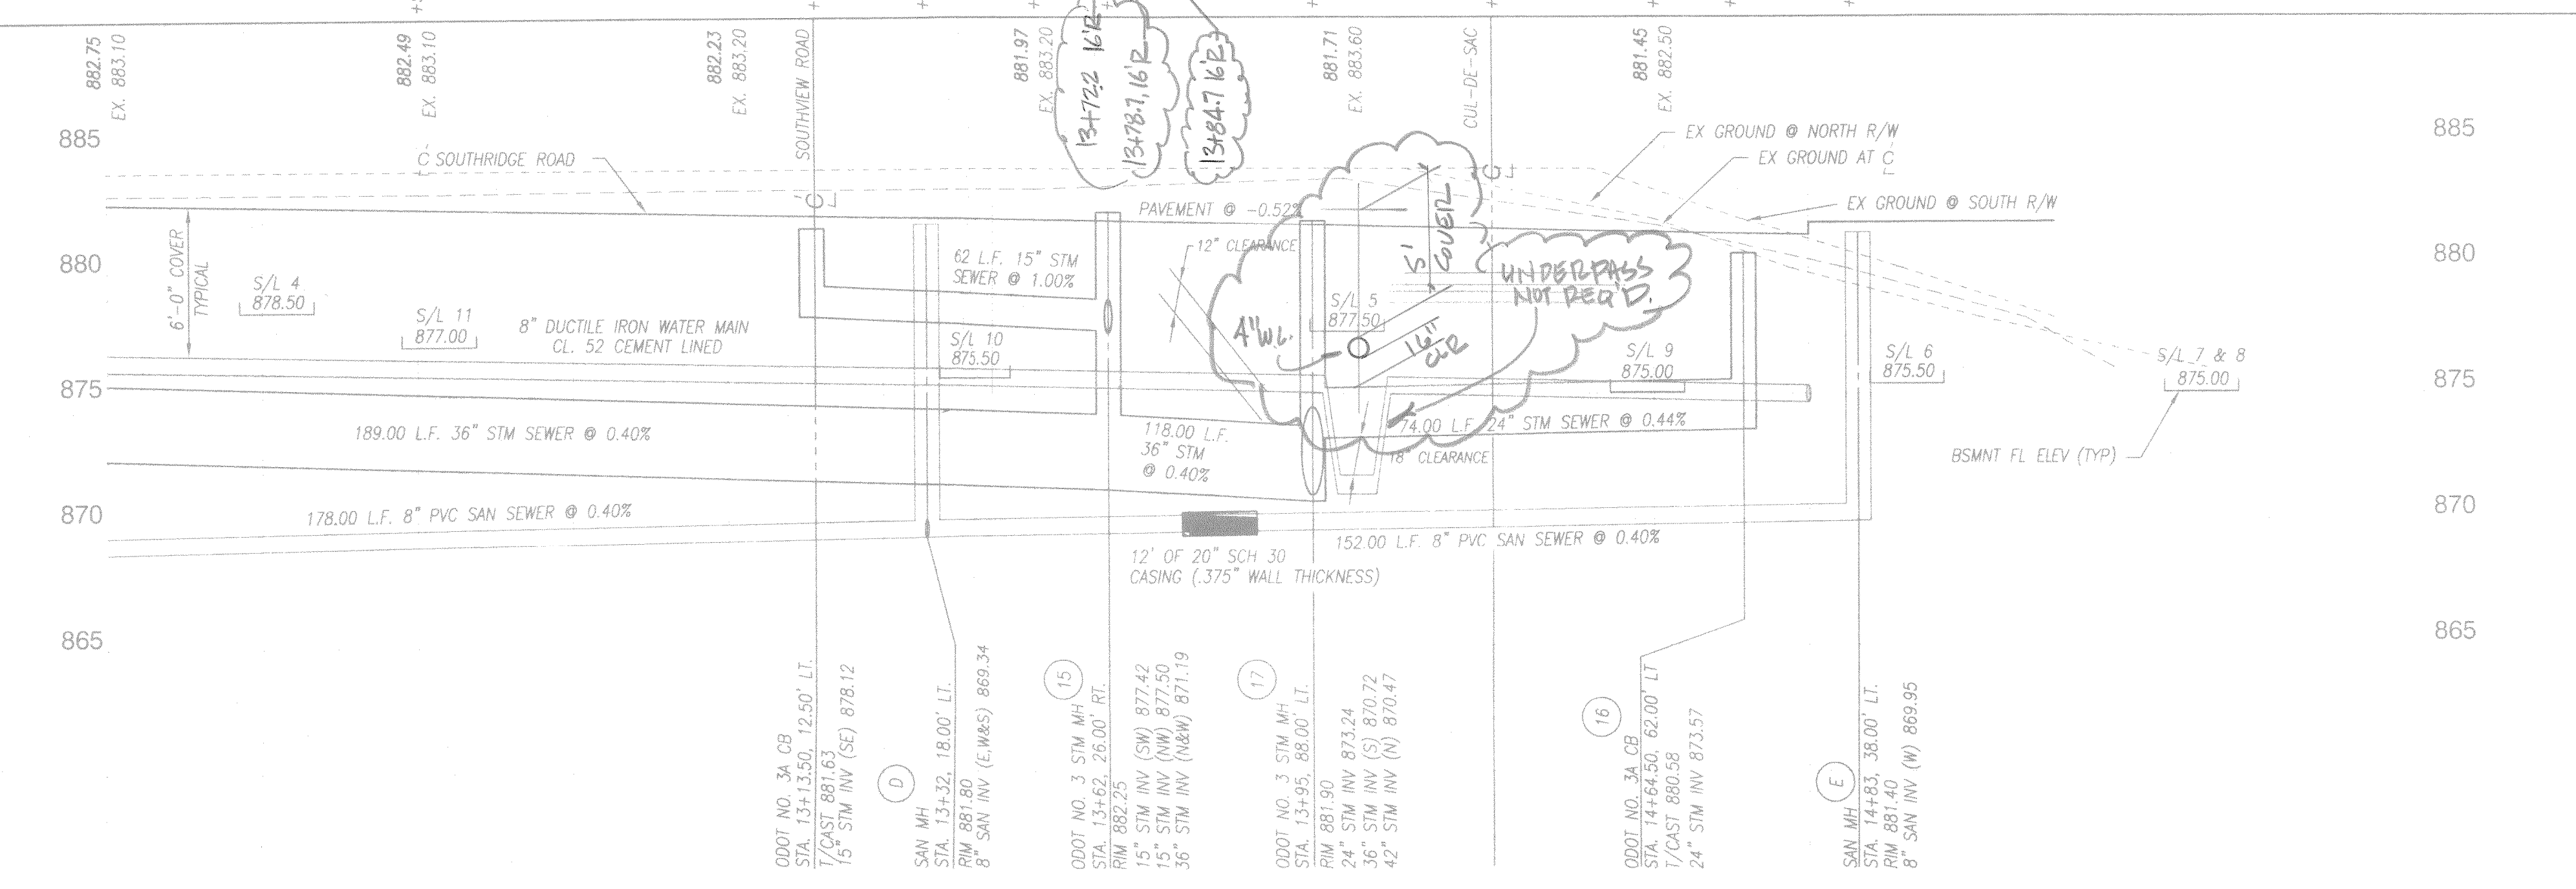

5080
140