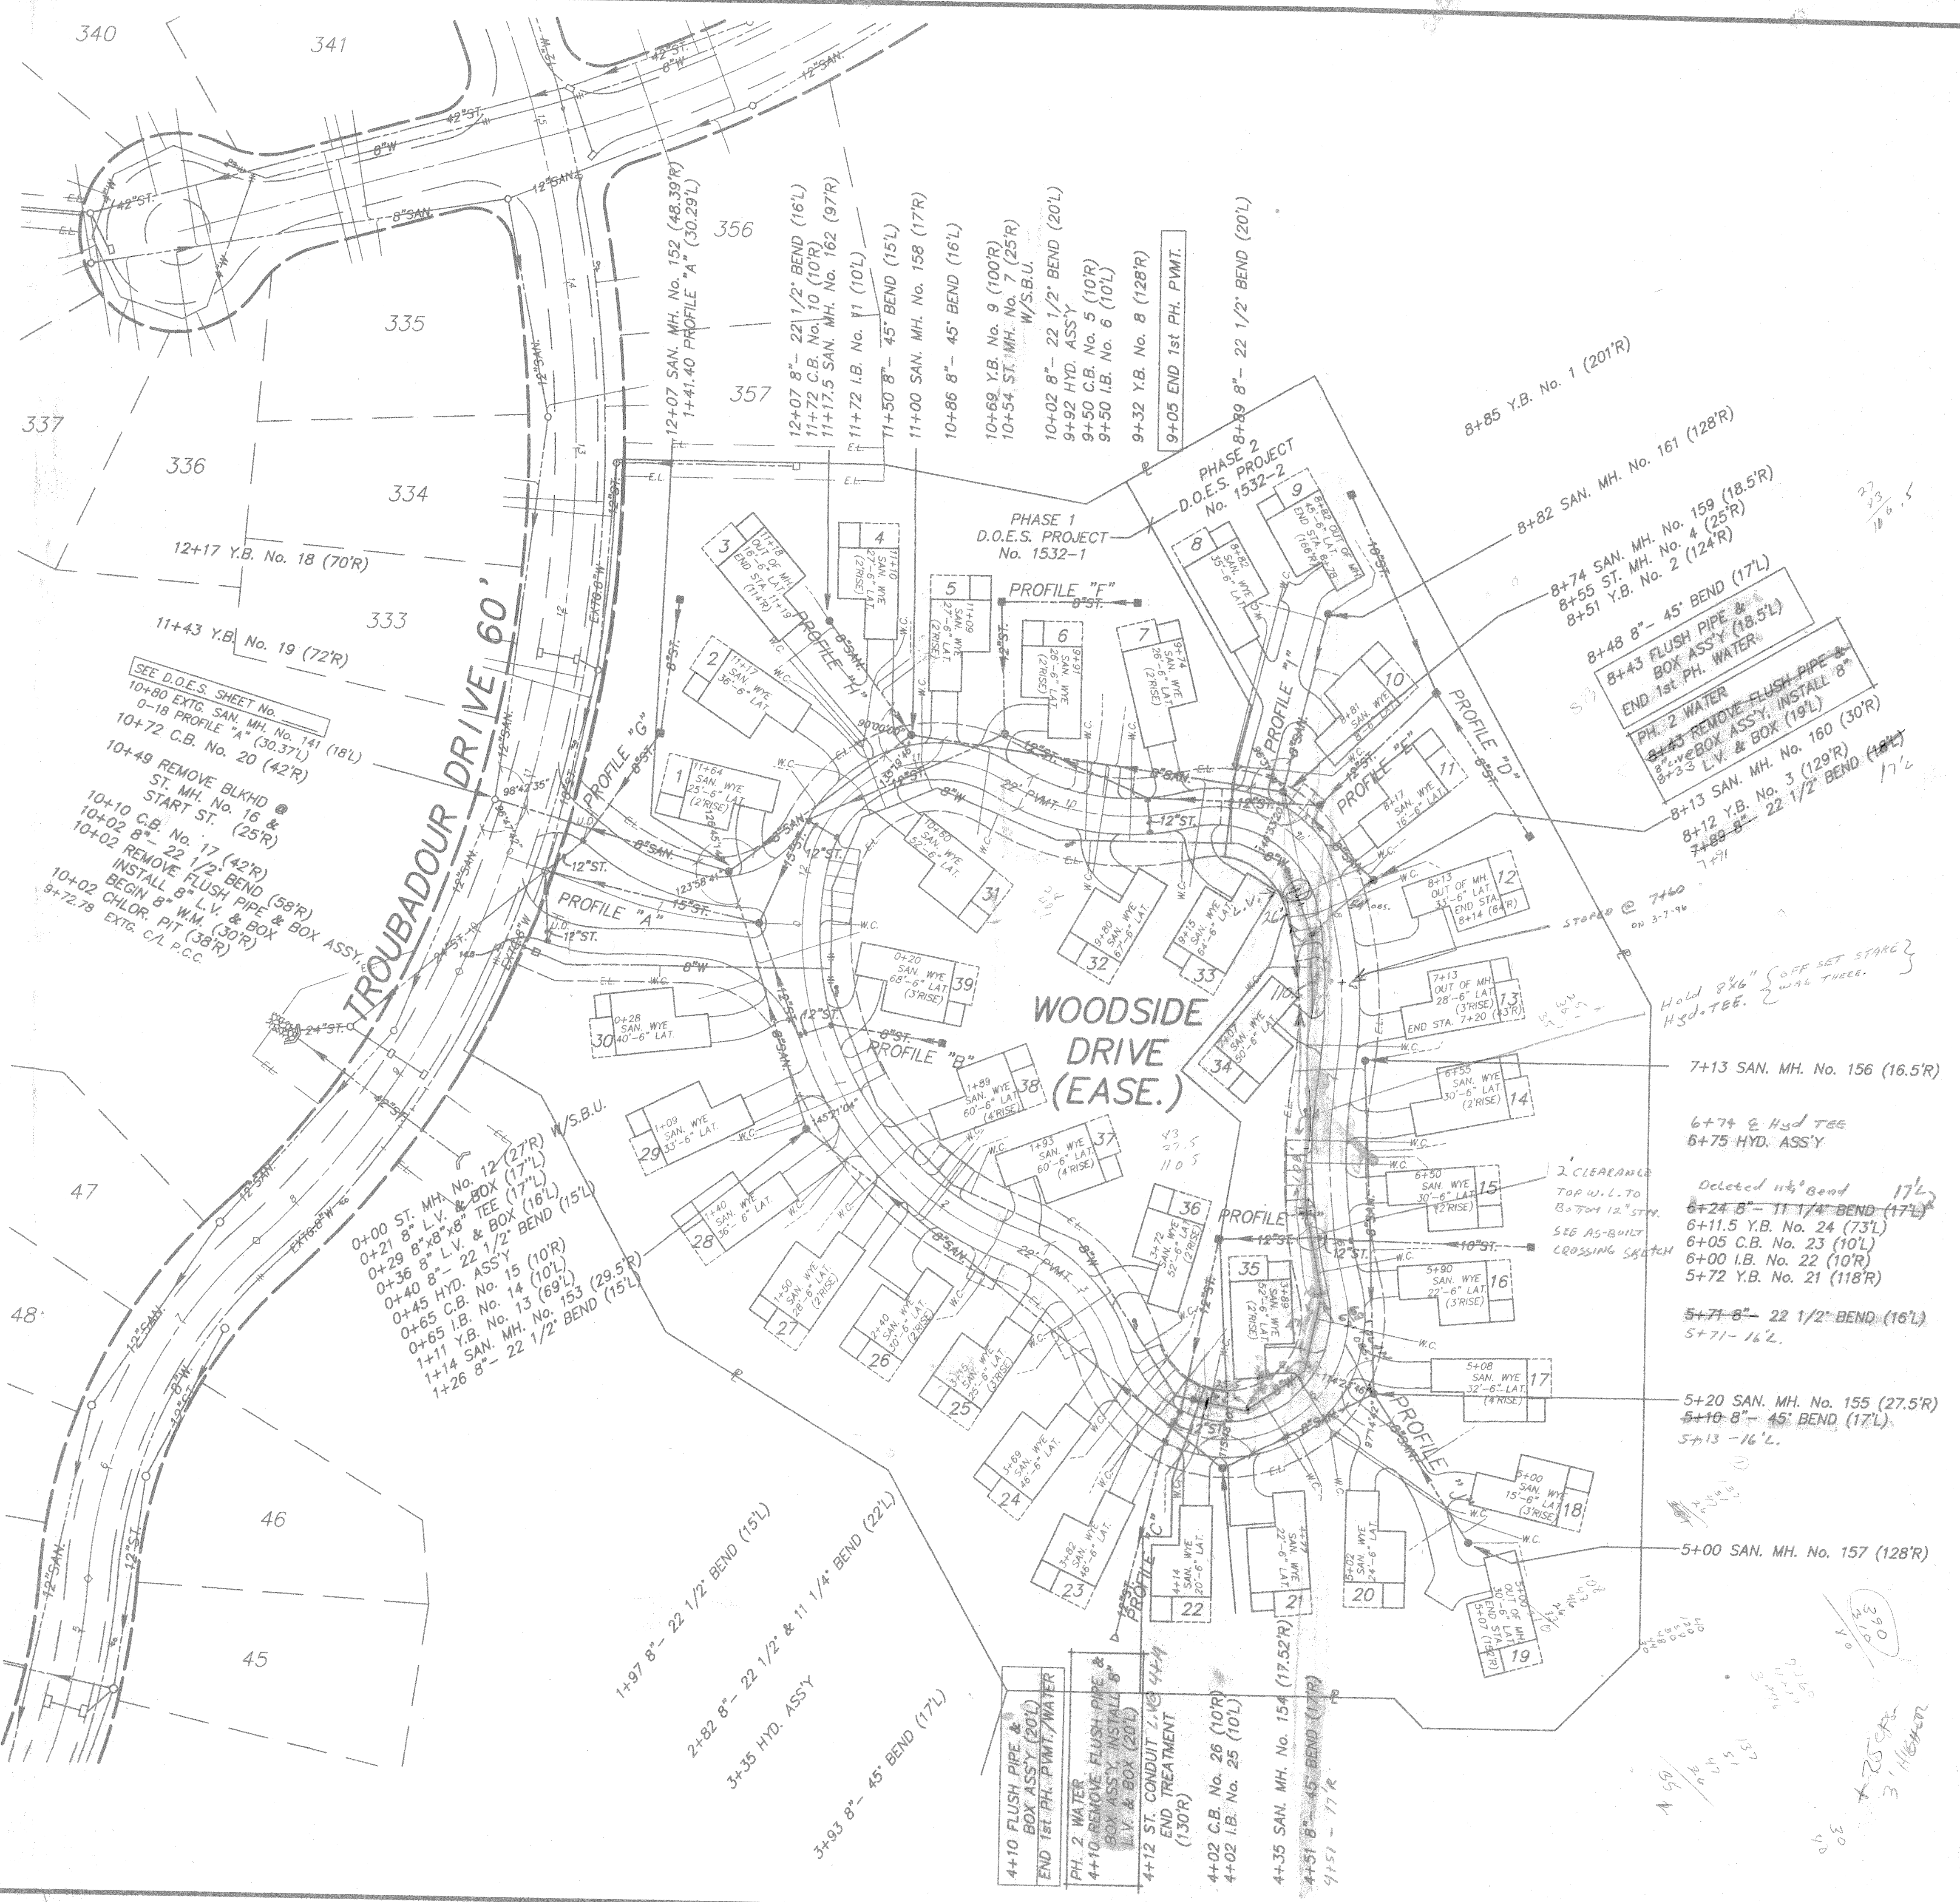


DATE	REVISIONS	BY
4/26/96	PER D.O.E.S. REVIEW	B.A.
5/15/96	PER D.O.E.S. REVIEW	B.K.
5/15/96	PER C.W.D. REVIEW	B.K.
10/2/96	PER CLIENT	R.R.
10/11/96	PER N.H.W.D. ENGINEER	R.R.

CONNECTION CHART			
PHASE	UNIT NO.	1" WATER CONNECTION TAP STATION	1 1/2" 3-PLY WATER CONNECTION TAP STATION
1	1	12+31	
	2		
	3		11+30
	4		
	5	10+90	
	6	9+86	
	7	9+62	
	8		
	9		8+95
	10		
2	11	8+21	
	12	8+02	
	13	7+18	
	14	6+62	
	15	6+49	
	16	5+85	
	17	5+83	
	18		
	19		5+03
	20		
1	21	4+67	
	22	4+18	
	23	3+89	
	24	3+54	
	25	3+11	
	26	2+39	
	27	1+59	
	28	1+35	
	29	1+11	
	30	1+94	
2	31	10+37	
	32	9+82	
	33	9+32	
	34	7+70	
	35	4+21	
	36	3+45	
	37	2+11	
	38	1+83	
	39	12+31	

NOTE 2 CONTRACTOR WIPED
GOT ALL STAKES FOR
CONTROL. CAME OFF OF
EXISTING MAN HOLES.
HOLD AS-BUILT STATION OF
HYDRANT ETC.

BENCH MARK
TOP OF HYDRANT
STA. 4+97. TROUBADOUR DRIVE
ELEV. 901.30

NOTE:
SANITARY LATERALS AND MAINLINE SANITARY
SEWER OVER STORM SEWERS SHALL HAVE
LIMESTONE BEDDING BETWEEN THE STORM
SEWER AND THE LATERAL OR MAINLINE
SANITARY SEWER THE WIDTH OF THE STORM
SEWER TRENCH.

SEE SHEET 7 FOR C/L GEOMETRY

LOCATION PLAN
EATON ESTATE ~ BLOCK 3-A
"WOODSIDE" CLUSTER DEV.
SAGAMORE HILLS, OHIO

DONALD G. BOHNING & ASSOCIATES, INC.
CIVIL ENGINEERING & SURVEYING
7709 HOBARTWAY - VALLEY VIEW, OHIO 44125-2 (216) 943-1120

APPROVED AS NOTED
BY SDW DATE 2/27/97
SEYMOUR D. WEISS & ASSOCIATES

DATE	REV.	CHK.	DATE
R.R.	E.K.	MAR. 1996	6
FILE NO.	ORDER NO.	226134UT	2261-34